MILWAUKEE COUNTY JAIL & CRIMINAL JUSTICE FACILITY

949 NORTH 9th STREET
MILWAUKEE, WISCONSIN
MILWAUKEE COUNTY PROJECT NO. 01-4436

BID PACKAGE 3
AUGUST 6, 1990

MILWAUKEE COUNTY
DEPARTMENT OF PUBLIC WORKS
PROJECT MANAGER

WILLIAM HEINEMANN
DIRECTOR
ARCHITECTURAL SERVICES
907 NORTH 10th STREET (RM. 320)
MILWAUKEE,WI 53233
(414) 278-4846

VENTURE ARCHITECTS
ARCHITECTS
205 WEST HIGHLAND
MILWAUKEE, WI 53203
(414) 271-3359
A JOINT VENTURE OF
KAHLER SLATER TORPHY ARCHITECTS
& the ZIMMERMAN DESIGN GROUP

THE McGOUGH GROUP, INC.
WITH ROBERT GLASS & ASSOC., INC.
SECURITY
WEST 245 SPOKANE FALLS BLVD.
SPOKANE, WA 99201
(509) 455-7050

GRAEF, ANHALT, SCHLOEMER & ASSOC., INC.
STRUCTURAL
345 NORTH 95th STREET
MILWAUKEE, WI 53226
(414) 259-1500

DANIEL C. SMITH & ASSOC.
COURTS
428 J STREET, SUITE 300
SACRAMENTO, CA 95814
(916) 456-9511

JASPAL ENGINEERING SERVICES, INC.
MECHANICAL
7618 WESTWARD WAY
MADISON, WI 53717
(608) 833-7000

STEWART DESIGN ASSOC., INC.
FOOD SERVICE
2934 FISH HATCHERY ROAD, SUITE 212
MADISON, WI 53713
(608) 271-8554

ARNOLD & O'SHERIDAN
ELECTRICAL
4125 NORTH 124th STREET
BROOKFIELD, WI 53005
(414) 783-6130

STEINMANN GRAYSON SMYLIE
FURNITURE, FURNISHINGS & EQUIPMENT
6310 SAN VICENTE BLVD., SUITE 500
LOS ANGELES, CA 90048
(213) 933-5050

CRSS/BOLDT
CONSTRUCTION MANAGER
949 NORTH 9th STREET
MILWAUKEE; WI 53233
(414) 225-0034

WISCONSIN — DAVID T. KAHLER — A-02843 — MILWAUKEE — ARCHITECT
WISCONSIN — GARY V. ZIMMERMAN — A-07644 — MILWAUKEE — ARCHITECT
ARCHITECTURAL VOLS 1&2

WISCONSIN — RICHARD M. BOB — E-16825 — PROFESSIONAL ENGINEER
STRUCTURAL VOL 2 (PART)

WISCONSIN — SARABJIT SINGH JASPAL — E-17281 — MADISON, WIS. — PROFESSIONAL ENGINEER
MECHANICAL VOL 3

WISCONSIN — CHARLES H. GEIGER — SUSSEX, WI — PROFESSIONAL ENGINEER
ELECTRICAL VOL 4

SHEET INDEX

VOLUME 1
T-1 TITLE SHEET

SITEWORK
SITE-1 SITE SURVEY - EXISTING TOPOGRAPHY & PROPERTY LINES
SITE-2 SITE SURVEY - EXISTING UTILITIES
SITE-3 SITE DEMOLITION PLAN
SITE-4 SITE DEVELOPMENT PLAN
SITE-5 SITE DETAILS & SECTIONS
SITE-6 SITE DETAILS & SECTIONS
SITE-7 PLANTING PLAN & SCHEDULE

CODE REQUIREMENTS
CR-1 BASEMENT, GROUND, FIRST, SECOND
CR-2 THIRD, FOURTH MAIN, FOURTH MEZZANINE
CR-3 FIFTH MAIN, FIFTH MEZZANINE, SIXTH MAIN, SIXTH MEZZANINE
CR-4 SEVENTH MAIN, SEVENTH MEZZANINE, PENTHOUSE

ARCHITECTURAL
A-100 BASEMENT
A-101 GROUND LEVEL
A-102 GROUND LEVEL AT TUNNEL
A-103 LEVEL ONE
A-104 LEVEL ONE AT SKYWALK
A-105 LEVEL TWO
A-106 LEVEL TWO AT SKYWALK
A-107 LEVEL THREE
A-108 ROOF AT SKYWALK
A-109 LEVEL FOUR MAIN
A-110 LEVEL FOUR MEZZANINE
A-111 LEVEL FIVE MAIN
A-112 LEVEL FIVE MEZZANINE
A-113 LEVEL SIX MAIN
A-114 LEVEL SIX MEZZANINE
A-115 LEVEL SEVEN MAIN
A-116 LEVEL SEVEN MEZZANINE
A-117 PENTHOUSE & ROOF PLAN
A-118 PENTHOUSE ROOF PLAN
A-119 NOT USED
A-120 GROUND LEVEL REFLECTED CEILING PLAN
A-121 LEVEL ONE REFLECTED CEILING PLAN
A-122 LEVEL TWO REFLECTED CEILING PLAN
A-123 LEVEL THREE REFLECTED CEILING PLAN
A-124 LEVEL FOUR MAIN REFLECTED CEILING PLAN
A-125 LEVEL FOUR MEZZANINE REFLECTED CEILING PLAN
A-126 LEVEL FIVE MAIN REFLECTED CEILING PLAN
A-127 LEVEL FIVE MEZZANINE REFLECTED CEILING PLAN
A-128 LEVEL SIX MAIN REFLECTED CEILING PLAN
A-129 LEVEL SIX MEZZANINE REFLECTED CEILING PLAN
A-130 LEVEL SEVEN MAIN REFLECTED CEILING PLAN
A-131 LEVEL SEVEN MEZZANINE REFLECTED CEILING PLAN
A-132 GROUND LEVEL SKYWALK REFLECTED CEILING PLAN
A-133 LEVEL ONE SKYWALK REFLECTED CEILING PLAN
A-134 LEVEL TWO SKYWALK REFLECTED CEILING PLAN
A-200 BUILDING ELEVATIONS
A-201 BUILDING ELEVATIONS
A-202 BUILDING ELEVATIONS
A-203 BUILDING ELEVATIONS
A-204 BUILDING ELEVATIONS
A-205 BUILDING ELEVATIONS
A-250 BUILDING SECTION
A-251 BUILDING SECTION
A-252 BUILDING SECTION
A-300 WALL SECTIONS
A-301 WALL SECTIONS
A-302 WALL SECTIONS
A-303 WALL SECTIONS
A-304 WALL SECTIONS
A-305 WALL SECTIONS
A-306 WALL SECTIONS
A-307 WALL SECTIONS
A-308 WALL SECTIONS
A-309 WALL SECTIONS
A-310 WALL SECTIONS
A-311 WALL SECTIONS
A-350 STAIR SECTIONS
A-351 STAIR SECTIONS
A-352 STAIR SECTIONS
A-353 STAIR SECTIONS
A-354 ELEVATOR HOISTWAY
A-355 ELEVATOR HOISTWAY
A-356 INTERIOR WALL & PARTITION SECTIONS
A-357 INTERIOR WALL & PARTITION SECTIONS
A-358 INTERIOR WALL & PARTITION SECTIONS
A-359 INTERIOR WALL & PARTITION SECTIONS/PNEUMATIC TUBE
A-400 GROUND LEVEL MASTER CONTROL/LOBBY - 1/4" PLAN
A-401 LEVEL ONE BOOKING - 1/4" PLAN
A-402 LEVEL ONE COURT STAGING/HIGH SECURITY - 1/4" PLAN
A-403 LEVEL TWO CIU/INTAKE COURT - 1/4" PLAN
A-404 LEVEL TWO MUNICIPAL/PRELIMINARY COURTS - 1/4" PLAN
A-405 LEVEL THREE SPECIAL NEEDS HOUSING - 1/4" PLAN
A-406 LEVEL THREE INFIRMARY/CLINIC - 1/4" PLAN
A-407 LEVEL THREE JAIL ADMINISTRATION/LOCKERS - 1/4" PLAN
A-408 MISCELLANEOUS PLANS - 1/4"
A-409 LOADING DOCK - 1/4"
A-410 TYPICAL HOUSING CELL PLANS & DETAILS
A-411 HOUSING POD SUPPORT PLANS
A-412 HOUSING PODS 5A & 5D
A-413 MAIN LEVEL HOUSING CORE PLAN & MISCELLANEOUS PLANS
A-414 GROUND & FIRST LEVEL FLOOR PATTERNS
A-415 SECOND LEVEL FLOOR PATTERNS
A-500 INTERIOR ELEVATIONS - GROUND LEVEL
A-501 INTERIOR ELEVATIONS - FIRST LEVEL
A-502 INTERIOR ELEVATIONS - FIRST, SECOND & THIRD LEVELS
A-503 INTERIOR ELEVATIONS - THIRD LEVEL
A-504 INTERIOR ELEVATIONS - THIRD LEVEL
A-505 INTERIOR ELEVATIONS - PUBLIC SPACES GROUND LEVEL
A-506 INTERIOR ELEVATIONS - PUBLIC SPACES GROUND LEVEL
A-507 INTERIOR ELEVATIONS - PUBLIC SPACES LEVEL ONE
A-508 INTERIOR ELEVATIONS - PUBLIC SPACES LEVEL TWO
A-509 INTERIOR ELEVATIONS - HOUSING
A-510 INTERIOR ELEVATIONS - TOILET ROOMS - GROUND & FIRST LEVELS
A-511 INTERIOR ELEVATIONS - TOILET ROOMS - FIRST & SECOND LEVELS
A-512 INTERIOR ELEVATIONS - TOILET ROOMS - THIRD LEVEL
A-513 INTERIOR ELEVATIONS - TOILET ROOMS - FOURTH THRU SEVENTH
A-514 INTERIOR ELEVATIONS/SECTIONS - INDIRECT PODS
A-520 INTERIOR ELEVATIONS - COURTS
A-600 MISCELLANEOUS MILLWORK
A-601 MISCELLANEOUS MILLWORK
A-602 MISCELLANEOUS MILLWORK
A-603 MISCELLANEOUS MILLWORK
A-604 COURTROOM MILLWORK
A-605 COURTROOM MILLWORK
A-606 MISCELLANEOUS MILLWORK
A-607 WORKSTATION MILLWORK

VOLUME 2
T-1 TITLE SHEET

CODE REQUIREMENTS
CR-1 BASEMENT, GROUND, FIRST, SECOND
CR-2 THIRD, FOURTH MAIN, FOURTH MEZZANINE
CR-3 FIFTH MAIN, FIFTH MEZZANINE, SIXTH MAIN, SIXTH MEZZANINE
CR-4 SEVENTH MAIN, SEVENTH MEZZANINE, PENTHOUSE

SIGNAGE
G-1 SITE SIGNAGE (SITE PLAN)
G-2 BASEMENT SIGNAGE (S1)
G-3 GROUND LEVEL SIGNAGE (S2 LOWER LEVEL SIGNAGE)
G-4 LEVEL ONE SIGNAGE (S3 GROUND LEVEL SIGNAGE)
G-5 LEVEL TWO SIGNAGE (S4 LEVEL ONE SIGNAGE)
G-6 LEVEL THREE SIGNAGE (S5 LEVEL TWO SIGNAGE)
G-7 LEVEL FOUR MAIN SIGNAGE (S6 LEVEL THREE SIGNAGE)
G-8 LEVEL FOUR MEZZANINE SIGNAGE (S7 LEVEL THREE MEZZ. SIGNAGE)
G-9 LEVEL FIVE MAIN SIGNAGE (S8 LEVEL FOUR MAIN SIGNAGE)
G-10 LEVEL FIVE MEZZANINE SIGNAGE (S9 LEVEL FOUR MEZZ. SIGNAGE)
G-11 LEVEL SIX MAIN SIGNAGE (S10 LEVEL FIVE MAIN SIGNAGE)
G-12 LEVEL SIX MEZZANINE SIGNAGE (S11 LEVEL FIVE MEZZ. SIGNAGE)
G-13 LEVEL SEVEN MAIN SIGNAGE (S12 LEVEL SIX SIGNAGE)
G-14 LEVEL SEVEN MEZZANINE SIGNAGE (S13 LEVEL SIX MEZZ. SIGNAGE)
G-15 PENTHOUSE SIGNAGE (S14)
G-16 PENTHOUSE MEZZANINE SIGNAGE (S15 PENTHOUSE MEZZ. & ROOF SIGNAGE)

FURNITURE FURNISHINGS & EQUIPMENT
FFE-1 GROUND LEVEL PLAN
FFE-2 FIRST LEVEL PLAN
FFE-3 SECOND LEVEL PLAN
FFE-4 THIRD LEVEL PLAN
FFE-5 SCHEDULES (FURNITURE SPECIFICATIONS)
FFE-6 FOURTH LEVEL MAIN PLAN
FFE-7 FOURTH LEVEL MEZZANINE PLAN
FFE-8 FIFTH LEVEL MAIN PLAN
FFE-9 FIFTH LEVEL MEZZANINE PLAN
FFE-10 SIXTH LEVEL MAIN PLAN
FFE-11 SIXTH LEVEL MEZZANINE PLAN
FFE-12 SEVENTH LEVEL MAIN PLAN
FFE-13 SEVENTH LEVEL MEZZANINE PLAN
FFE-14 1/4" WORKSTATION BLOW-UPS
FFE-15 1/4" WORKSTATION BLOW-UPS

VOLUME 2 (CONT.)
FOOD SERVICE
FS-1 MAIN KITCHEN PLAN
FS-2 MAIN KITCHEN ELECTRICAL ROUGH-IN
FS-3 MAIN KITCHEN PLUMBING ROUGH-IN
FS-4 LEVEL THREE & HOUSING LEVELS PLAN
FS-5 LEVEL THREE & HOUSING LEVELS ROUGH-INS
FS-6 SCHEDULES
FS-7 SCHEDULES
FS-8 EQUIPMENT ELEVATIONS

STRUCTURAL
S-201 INTERIOR SLABS ON GRADE LEVELS B, G & 1
S-208 LEVEL GROUND - MISCELLANEOUS CONCRETE FRAMING
S-212 SALLYPORT PLANS - LEVELS 1 & 2
S-218 MISCELLANEOUS CONCRETE, PRECAST & LIGHT GAGE METAL FRAMING
S-227 LEVEL FOUR MEZZANINE FRAMING PLAN
S-232 LEVEL FIVE MEZZANINE FRAMING PLAN
S-237 LEVEL SIX MEZZANINE FRAMING PLAN
S-242 LEVEL SEVEN MEZZANINE FRAMING PLAN
S-247 MAIN ROOF PENTHOUSE PLAN
S-310 SKYWALK FRAMING PLANS & ELEVATIONS
S-312 PARTIAL PLANS & ELEVATIONS - SKYWALKS SUPPORTS
S-315 DETAILS
S-316 SKYWALKS - DETAILS & SECTIONS
S-608 DETAILS
S-609 DETAILS & SECTIONS
S-612 DETAILS
S-640 DETAILS
S-650 DETAILS

INFORMATIONAL PURPOSES ONLY (dated 2/28/90)
S-211 LEVEL ONE MILD STEEL INSERT PLAN
S-216 LEVEL TWO MILD STEEL INSERT PLAN
S-221 LEVEL THREE MILD STEEL INSERT PLAN
S-226 LEVEL FOUR MILD STEEL INSERT PLAN
S-231 MILD STEEL INSERT PLAN LEVEL FIVE, SIX, SEVEN
S-246 ROOF LEVEL MILD STEEL INSERT PLAN

VOLUME 3
T-1 TITLE SHEET

CODE REQUIREMENTS
CR-1 BASEMENT, GROUND, FIRST, SECOND
CR-2 THIRD, FOURTH MAIN, FOURTH MEZZANINE
CR-3 FIFTH MAIN, FIFTH MEZZANINE, SIXTH MAIN, SIXTH MEZZANINE
CR-4 SEVENTH MAIN, SEVENTH MEZZANINE, PENTHOUSE

PLUMBING
P-001 DRAWING INDEX, SYMBOLS, ABBREVIATIONS
M-100 MECHANICAL SITE PLAN
P-100 FOUNDATION - BASEMENT LEVEL
P-101 FOUNDATION - GROUND LEVEL
P-102 FOUNDATION - TRANSFER GIRDER PLAN
P-200 LEVEL GROUND
P-201 LEVEL 1
P-202 LEVEL 2
P-203 LEVEL 3
P-204 LEVEL 4
P-204M LEVEL 4 MEZZANINE
P-205 LEVEL 5
P-205M LEVEL 5 MEZZANINE
P-206 LEVEL 6
P-206M LEVEL 6 MEZZANINE
P-207 LEVEL 7
P-207M LEVEL 7 MEZZANINE
P-208 PENTHOUSE LEVEL
P-209 PENTHOUSE ROOF PLAN
P-210 SKYWALK - ROOF PLAN
P-211 SKYWALK - LEVEL 2
P-212 MECHANICAL ROOM G0015 & DIAGRAMS
P-500 POD A - STACK DIAGRAMS
P-501 POD B - STACK DIAGRAMS
P-502 POD C - STACK DIAGRAMS
P-503 POD D - STACK DIAGRAMS
P-504 SOIL STACK RISER DIAGRAMS
P-505 SOIL STACK RISER DIAGRAMS
P-506 DIAGRAMS
P-507 WASTE STACK RISER DIAGRAMS
P-508 WASTE STACK RISER DIAGRAMS
P-509 WASTE STACK RISER DIAGRAMS
P-510 DIAGRAMS
P-511 DIAGRAMS
P-520 POD A, B, C & D - WATER RISER DIAGRAMS
P-521 WATER RISER DIAGRAMS & DETAILS
P-530 HOUSING CELL CHASE PLANS & ISOMETRICS
P-550 FIRE PROTECTION SYSTEM SCHEMATIC
P-551 FIRE PROTECTION DIAGRAMS
P-552 FIRE PROTECTION DETAILS
P-553 FIRE PROTECTION SPRINKLER ZONES
P-554 FIRE PROTECTION SPRINKLER ZONES
P-555 FIRE PROTECTION SPRINKLER ZONES
P-556 FIRE PROTECTION SPRINKLER ZONES
P-700 PLUMBING DETAILS
P-701 PLUMBING DETAILS
P-702 KITCHEN SCHEDULE & DETAILS

HVAC
M-001 DRAWING INDEX, SYMBOLS, ABBREVIATIONS
M-201 LEVEL GROUND - DUCTWORK
M-202 LEVEL GROUND - PIPING
M-203 LEVEL 1 - DUCTWORK
M-204 LEVEL 1 - PIPING
M-205 LEVEL 2 - DUCTWORK
M-206 LEVEL 2 - PIPING
M-207 LEVEL 3 - DUCTWORK
M-208 LEVEL 3 - PIPING
M-209 LEVEL 4 MAIN, PODS
M-210 LEVEL 4 MEZZANINE, PODS
M-211 LEVEL 4 MAIN, CORE
M-212 LEVEL 4 MEZZANINE, CORE
M-213 LEVEL 5 MAIN, PODS
M-214 LEVEL 5 MEZZANINE, PODS
M-215 LEVEL 5 MAIN, CORE
M-216 LEVEL 5 MEZZANINE, CORE
M-217 LEVEL 6 MAIN, PODS
M-218 LEVEL 6 MEZZANINE, PODS
M-219 LEVEL 6 MAIN, CORE
M-220 LEVEL 6 MEZZANINE, CORE
M-221 LEVEL 7 MAIN, PODS
M-222 LEVEL 7 MEZZANINE, PODS
M-223 LEVEL 7 MAIN, CORE
M-224 LEVEL 7 MEZZANINE, CORE
M-301 COMPOSITE ROOF PLAN & ELEVATOR EQUIPMENT ROOMS
M-321 BASEMENT MECHANICAL PLAN
M-322 LEVEL 2 - TUNNEL & CENTRAL SERVICES MECHANICAL PLANS
M-323 LEVEL 3 & HIGH SECURITY COURT MECHANICAL PLANS
M-324 LEVEL 4 & GROUND MECHANICAL PLANS
M-325 PENTHOUSE MECHANICAL PLAN
M-341 LEVEL GROUND - SKYWALK
M-342 LEVEL 1 - SKYWALK
M-343 LEVEL 2 - SKYWALK
M-361 CELL PLAN & SECURITY DETAILS
M-381 STAIR PIPING & DUCTWORK - PLANS & SECTIONS
M-382 STAIR PIPING & DUCTWORK - PLANS & SECTIONS
M-383 STAIR PIPING & DUCTWORK - PLANS & SECTIONS
M-601 HVAC SCHEDULES
M-602 HVAC SCHEDULES
M-603 HVAC SCHEDULES
M-701 HVAC DETAILS
M-702 HVAC DETAILS
M-801 SYSTEM SCHEMATICS - AIR
M-821 SYSTEM SCHEMATICS - WATER, STEAM
M-831 SYSTEM SCHEMATICS - STAIR PRESSURE
M-841 SYSTEM SCHEMATICS - CONTROLS
M-842 SYSTEM SCHEMATICS - CONTROLS
M-843 SYSTEM SCHEMATICS - CONTROLS

VOLUME 4
T-1 TITLE SHEET

CODE REQUIREMENTS
CR-1 BASEMENT, GROUND, FIRST, SECOND
CR-2 THIRD, FOURTH MAIN, FOURTH MEZZANINE
CR-3 FIFTH MAIN, FIFTH MEZZANINE, SIXTH MAIN, SIXTH MEZZANINE
CR-4 SEVENTH MAIN, SEVENTH MEZZANINE, PENTHOUSE

ELECTRICAL
E-1 SYMBOLS & ABBREVIATIONS
E-2 ELECTRICAL SITE PLAN
E-3 ENLARGED PARTIAL SITE PLANS
E-4 DETAILS
E-5 BASEMENT LEVEL - LIGHTING
E-6 BASEMENT LEVEL - POWER
E-7 BASEMENT LEVEL - SYSTEMS
E-8 GROUND LEVEL - LIGHTING
E-9 GROUND LEVEL - POWER
E-10 GROUND LEVEL - COMMUNICATION SYSTEMS
E-11 GROUND LEVEL - DOOR CONTROL & VSS SYSTEMS
E-12 ENLARGED KITCHEN FLOOR PLAN & KITCHEN SPECIAL OUTLET SCHEDULE
E-13 FIRST LEVEL - LIGHTING
E-14 FIRST LEVEL - POWER
E-15 FIRST LEVEL - COMMUNICATION SYSTEMS
E-16 FIRST LEVEL - DOOR CONTROL & VSS SYSTEMS
E-17 SECOND LEVEL - LIGHTING
E-18 SECOND LEVEL - POWER
E-19 SECOND LEVEL - COMMUNICATION SYSTEMS
E-20 SECOND LEVEL - DOOR CONTROL & VSS SYSTEMS
E-21 THIRD LEVEL - LIGHTING
E-22 THIRD LEVEL - POWER
E-23 THIRD LEVEL - COMMUNICATION SYSTEMS
E-24 THIRD LEVEL - DOOR CONTROL & VSS SYSTEMS
E-25 ENLARGED PARTIAL FLOOR PLAN & DETAILS
E-26 DETAILS
E-27 FOURTH LEVEL MAIN - LIGHTING
E-28 FOURTH LEVEL MAIN - POWER
E-29 FOURTH LEVEL MAIN - COMMUNICATION SYSTEMS
E-30 FOURTH LEVEL MAIN - DOOR CONTROL & VSS SYSTEMS
E-31 FOURTH LEVEL MEZZANINE - LIGHTING
E-32 FOURTH LEVEL MEZZANINE - POWER
E-33 FOURTH LEVEL MEZZANINE - COMMUNICATION SYSTEMS
E-34 FOURTH LEVEL MEZZANINE - DOOR CONTROL & VSS SYSTEMS
E-35 FIFTH LEVEL MAIN - LIGHTING
E-36 FIFTH LEVEL MAIN - POWER
E-37 FIFTH LEVEL MAIN - COMMUNICATION SYSTEMS
E-38 FIFTH LEVEL MAIN - DOOR CONTROL & VSS SYSTEMS
E-39 FIFTH LEVEL MEZZANINE - LIGHTING
E-40 FIFTH LEVEL MEZZANINE - POWER
E-41 FIFTH LEVEL MEZZANINE - COMMUNICATION SYSTEMS
E-42 FIFTH LEVEL MEZZANINE - DOOR CONTROL & VSS SYSTEMS
E-43 SIXTH LEVEL MAIN - LIGHTING
E-44 SIXTH LEVEL MAIN - POWER
E-45 SIXTH LEVEL MAIN - COMMUNICATION SYSTEMS
E-46 SIXTH LEVEL MAIN - DOOR CONTROL & VSS SYSTEMS
E-47 SIXTH LEVEL MEZZANINE - LIGHTING
E-48 SIXTH LEVEL MEZZANINE - POWER
E-49 SIXTH LEVEL MEZZANINE - COMMUNICATION SYSTEMS
E-50 SIXTH LEVEL MEZZANINE - DOOR CONTROL & VSS SYSTEMS
E-51 SEVENTH LEVEL MAIN - LIGHTING
E-52 SEVENTH LEVEL MAIN - POWER
E-53 SEVENTH LEVEL MAIN - COMMUNICATION SYSTEMS
E-54 SEVENTH LEVEL MAIN - DOOR CONTROL & VSS SYSTEMS
E-55 SEVENTH LEVEL MEZZANINE - LIGHTING
E-56 SEVENTH LEVEL MEZZANINE - POWER
E-57 SEVENTH LEVEL MEZZANINE - COMMUNICATION SYSTEMS
E-58 SEVENTH LEVEL MEZZANINE - DOOR CONTROL & VSS SYSTEMS
E-59 PENTHOUSE - LIGHTING
E-60 PENTHOUSE - POWER
E-61 PENTHOUSE - SYSTEMS
E-62 ROOF - LIGHTING
E-63 ROOF - POWER
E-64 ROOF - SYSTEMS
E-65 TYPICAL CELL PLANS & DETAILS
E-66 ENLARGED PARTIAL FLOOR PLANS & DETAILS
E-67 COURTHOUSE CONNECTION GROUND LEVEL - LIGHTING
E-68 COURTHOUSE CONNECTION GROUND LEVEL - POWER & SYSTEMS
E-69 COURTHOUSE & SAFETY BUILDING CONNECTION LEVEL 1 - LIGHTING
E-70 COURTHOUSE & SAFETY BUILDING CONNECTION LEVEL 1 - POWER & SYSTEMS
E-71 COURTHOUSE & SAFETY BUILDING CONNECTION LEVEL 2 - LIGHTING
E-72 COURTHOUSE & SAFETY BUILDING CONNECTION LEVEL 2 - POWER & SYSTEMS
E-73 LIGHTING FIXTURE & LIGHTING CONTROL SCHEDULES
E-74 MOTOR WIRING SCHEDULE
E-75 SPECIAL OUTLET & MOTOR CONTROL CENTER SCHEDULES
E-76 PANEL, TIME CLOCK & CONTACTOR SCHEDULES
E-77 SECURITY CONTROL PANEL ELEVATIONS
E-78 SECURITY CONTROL PANEL ELEVATIONS
E-79 SECURITY CONTROL PANEL ELEVATIONS
E-80 SECURITY CONTROL PANEL ELEVATIONS
E-81 SECURITY CONTROL PANEL ELEVATIONS
E-82 SECURITY CONTROL PANEL ELEVATIONS
E-83 SECURITY CONTROL PANEL ELEVATIONS
E-84 SECURITY CONTROL PANEL ELEVATIONS
E-85 SECURITY CONTROL PANEL ELEVATIONS
E-86 SECURITY CONTROL PANEL ELEVATIONS
E-87 SECURITY CONTROL PANEL ELEVATIONS
E-88 FACILITY INTERCOM MATRIX & DETAILS
E-89 SYSTEM RISER DIAGRAMS
E-90 SYSTEM RISER DIAGRAMS
E-90A SYSTEM RISER DIAGRAMS
E-91 DOOR CONTROL WIRING DIAGRAMS
E-92 DOOR CONTROL WIRING DIAGRAMS
E-93 DOOR CONTROL WIRING DIAGRAMS
E-94 DOOR CONTROL WIRING DIAGRAMS
E-95 DOOR CONTROL WIRING DIAGRAMS
E-96 DOOR CONTROL WIRING DIAGRAMS
E-97 DOOR CONTROL WIRING DIAGRAMS
E-98 DOOR CONTROL WIRING DIAGRAMS
E-99 DOOR CONTROL WIRING DIAGRAMS
E-100 DOOR CONTROL WIRING DIAGRAMS
E-101 DOOR CONTROL WIRING DIAGRAMS
E-102 DOOR CONTROL WIRING DIAGRAMS
E-103 ONE-LINE POWER DIAGRAM
E-104 ONE-LINE POWER DIAGRAM
E-105 ONE-LINE POWER DIAGRAM
E-106 EQUIPMENT ELEVATIONS

C.D. SMITH CONSTRUCTION
P.O. Box 1006 • Phone: 1-(414) 922-0421
Fond du Lac WI 54936-1006

AS BUILT
DRWGS
VOLUME 1

MILWAUKEE COUNTY DEPARTMENT OF PUBLIC WORKS
PROFESSIONAL SERVICES DIVISION
COURTHOUSE ANNEX • 907 NORTH 10TH STREET • MILWAUKEE, WI 53233

FACILITY MANAGEMENT APPROVAL BY
DATE
PROJECT APPROVAL BY
DIRECTOR - DEPARTMENT OF PUBLIC WORKS
DATE [illegible]

REVISIONS

PROJECT NO. 01-4436
SHEET NO. T-1 OF
FILE NO. E-7-6

CHANGE DOCUMENTS:
RFI 20-396 WO#81
CP - 996
CP - 986
CP - 1000
CP - 1023

SITE DEVELOPMENT PLAN

1" = 20'-0"

W. STATE STREET
ONE WAY
TWO WAY
NEW GRADES, North Side
SEE SALLYPORT EXIT NORTH FRONTAGE ROAD SITE - 6
SHOW IDENTIFICATION STAMPS ON PROPOSED FRONTAGE ROAD SEE DETAIL A/SITE - 5
EXIST. DIM. F.O.C. TO F.O.C. TO REMAIN
EXIST. TO REMAIN
SEE DETAIL G SITE-5/SITE-6
SEE DETAIL G/ SITE - 5
SEE DETAIL H SITE-5/SITE-6
SEE DETAIL H/ SITE - 5
NEW PROPERTY LINE
SALLYPORT EXIT
2'0" TYP. MIN. DIMEN P.L. TO FACE OF CURB
TOP OF CONC. CURB @ BUILDING TO BE 3" (TYP) BELOW TOP OF STONE LEDGE
EXIST. TO REMAIN
NEW WORK
EXIST. DIM. F.O.C. TO F.O.C. TO REMAIN
BUILDING COLUMN GRID LINES - TYP.
2'0" FACE TO FACE OF CURB
3'0"± TO JOINT
EXIST TO REMAIN
MIS CLEANOUT MH'S TO REMAIN. CONTRACTOR TO RAISE MH'S & COVERS AS NECESSARY TO MATCH NEW SIDEWALK/STREET ELEV. PER MMSD STANDARDS.
MMSD OWNER REMAR'S BY C.O.# 24 W/ REMOVEABLE SLAB
MIS CLEANOUTS & MH'S
EXIST'G CURB & GUTTER TO REMAIN
EXISTING CURB & GUTTER TO REMAIN
I-43 SOUTHBOUND ON-RAMP
NOTE: EXPANSION JOINT REQ'D EVERY 100 FT. OF SIDEWALK SEE DETAIL J - SITE 4
EDGE OF TUNNEL
63.5 N. BOUND OFF-RAMP BELOW BLDG.
1 EA SIDE
3'0" 6'0"
STREET
10TH
NORTH
9TH
NEW CURB
NEW PROPERTY LINE
EXISTING CURB & GUTTER SALLYPORT REMAIN COMMUNIX BY CONTE
36'10"
NEW WORK
40'0"R
FIELD LOCATE
20'0" TYP.
DUCTILE IRON SLOTTED RUN. EL 62.7
ADDENDUM 4 Pg. 44
EXIST TO REMAIN
SEE DETAIL H SITE - 5
SALLYPORT ENTRY
MANHOLES TO REMAIN. CONTRACTOR TO RAISE MH'S & COVERS AS NECESSARY TO MATCH NEW SIDEWALK/STREET ELEV. PER UTILITY STANDARDS
SEE DETAIL H SITE - 5
IN-FILL WALL
EXIST M.H. TO REMAIN
EXIST TO REMAIN
NEW CURB & GUTTER & WALK
8'0" TYP.
13'10"
EXISTING TO REMAIN
SEE SALLYPORT ENTRANCE NORTH 10TH STREET SITE - 6
MILWAUKEE COUNTY JAIL & CRIMINAL JUSTICE FACILITY

BASEMENT	EL = 34'-0"
LEVEL G	EL = 48'-0"
LEVEL 1	EL = 64'-0"
LEVEL 2	EL = 82'-0"
LEVEL 3	EL = 98'-0"
LEVEL 4 MAIN	EL = 114'-0"
LEVEL 4 MEZZ	EL = 122'-11"
LEVEL 5 MAIN	EL = 135'-4"
LEVEL 5 MEZZ	EL = 144'-3"
LEVEL 6 MAIN	EL = 156'-8"
LEVEL 6 MEZZ	EL = 165'-7"
LEVEL 7 MAIN	EL = 178'-0"
LEVEL 7 MEZZ	EL = 188'-11"
LEVEL ROOF/PENTHOUSE	EL = 199'-4"

MILWAUKEE COUNTY COURTHOUSE
SAFETY BUILDING
LOADING DOCK
LINE OF SKYWALK ABOVE
NEW CONC. WALK
SLOTTED GRATE W/ CATCH BASIN BELOW RIM EL 41.5
SEE DETAIL H/ SITE - 5
SEE DETAIL/ SITE - 5
FACE OF GRANITE WALL BELOW
EXIST. CURB & WALK TO REMAIN
SEE LOADING DOCK SITE PLAN SITE - 6
GRADE RAISED CP-996
NEW CONCRETE WALK
NEW PAVING SEE SHT. A-104
Fence & End CP-986
CP-996
ADDENDUM 4
9/11/90
A99-A7
RIO PROJ. 3

LEGEND

NEW GRADE	——51——
EXIST. GRADE	– – 51 – –
NEW CONCRETE	
NEW BUILDING	
PROPERTY LINE	— — —
SPOT ELEVATION	47.92
MANHOLE	MH
CONC STOOP/SLAB	
NEW LIGHT POLE SEE SHT E-2	LP
YEAR DRAIN/RIM EL SEE SHT	46.5
TREE PLANTER SEE SITE - 7	
EXIST. GRADE	
BOLLARD	

GENERAL NOTES:

1. SEE SHEET M - 100 FOR ALL PLUMBING & SEWERAGE WORK. SHEET M - 100 GOVERNS.
2. SEE SHEET E - 102 FOR ALL ELECTRICAL SITE WORK (TO INCLUDE LIGHT POLES, ETC.)

ADDENDUM 4 Pg. 44:

1. Contract 8 contractor to raise manholes on North 9th and 10th streets -- See Plumbing Drawings.
2. See Addendum Drawing ADD-A7 (Addendum No. 2) for clarification of walls at drive from North 10th street to Vehicle Sallyport entry. Note: See page 30.006, attached to this addendum, for wall detail.
3. Fill Pavement Joints w/ City of Milwaukee R.O.W. w/ ASTM D3405 Joint Filler W.O.# 81

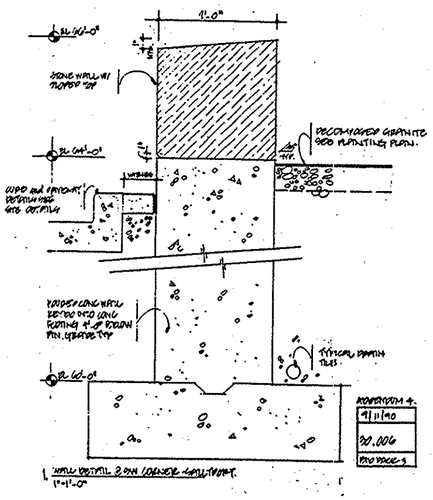

Venture Architects

Joint Venture of:
the Zimmerman Design Group
Kohler Slater Toohy Architects
Architect Number 8003

MILWAUKEE COUNTY DEPARTMENT OF PUBLIC WORKS
PROFESSIONAL SERVICES DIVISION
COURTHOUSE ANNEX 807 NORTH 10TH STREET, MILWAUKEE, WISCONSIN 53233

REVISIONS
AS-BUILT

DRAWN BY: P. A. ROPER, INC.
CHECKED BY:
SCALE: AS SHOWN
DATE: 8-6-90

PROJECT TITLE: MILWAUKEE COUNTY JAIL & CRIMINAL JUSTICE FACILITY Milwaukee Wisconsin
SHEET DESCRIPTION: SITE DEVELOPMENT PLAN

PROJECT NO. 10-4436

SHEET NO. SITE-4
FILE NO.

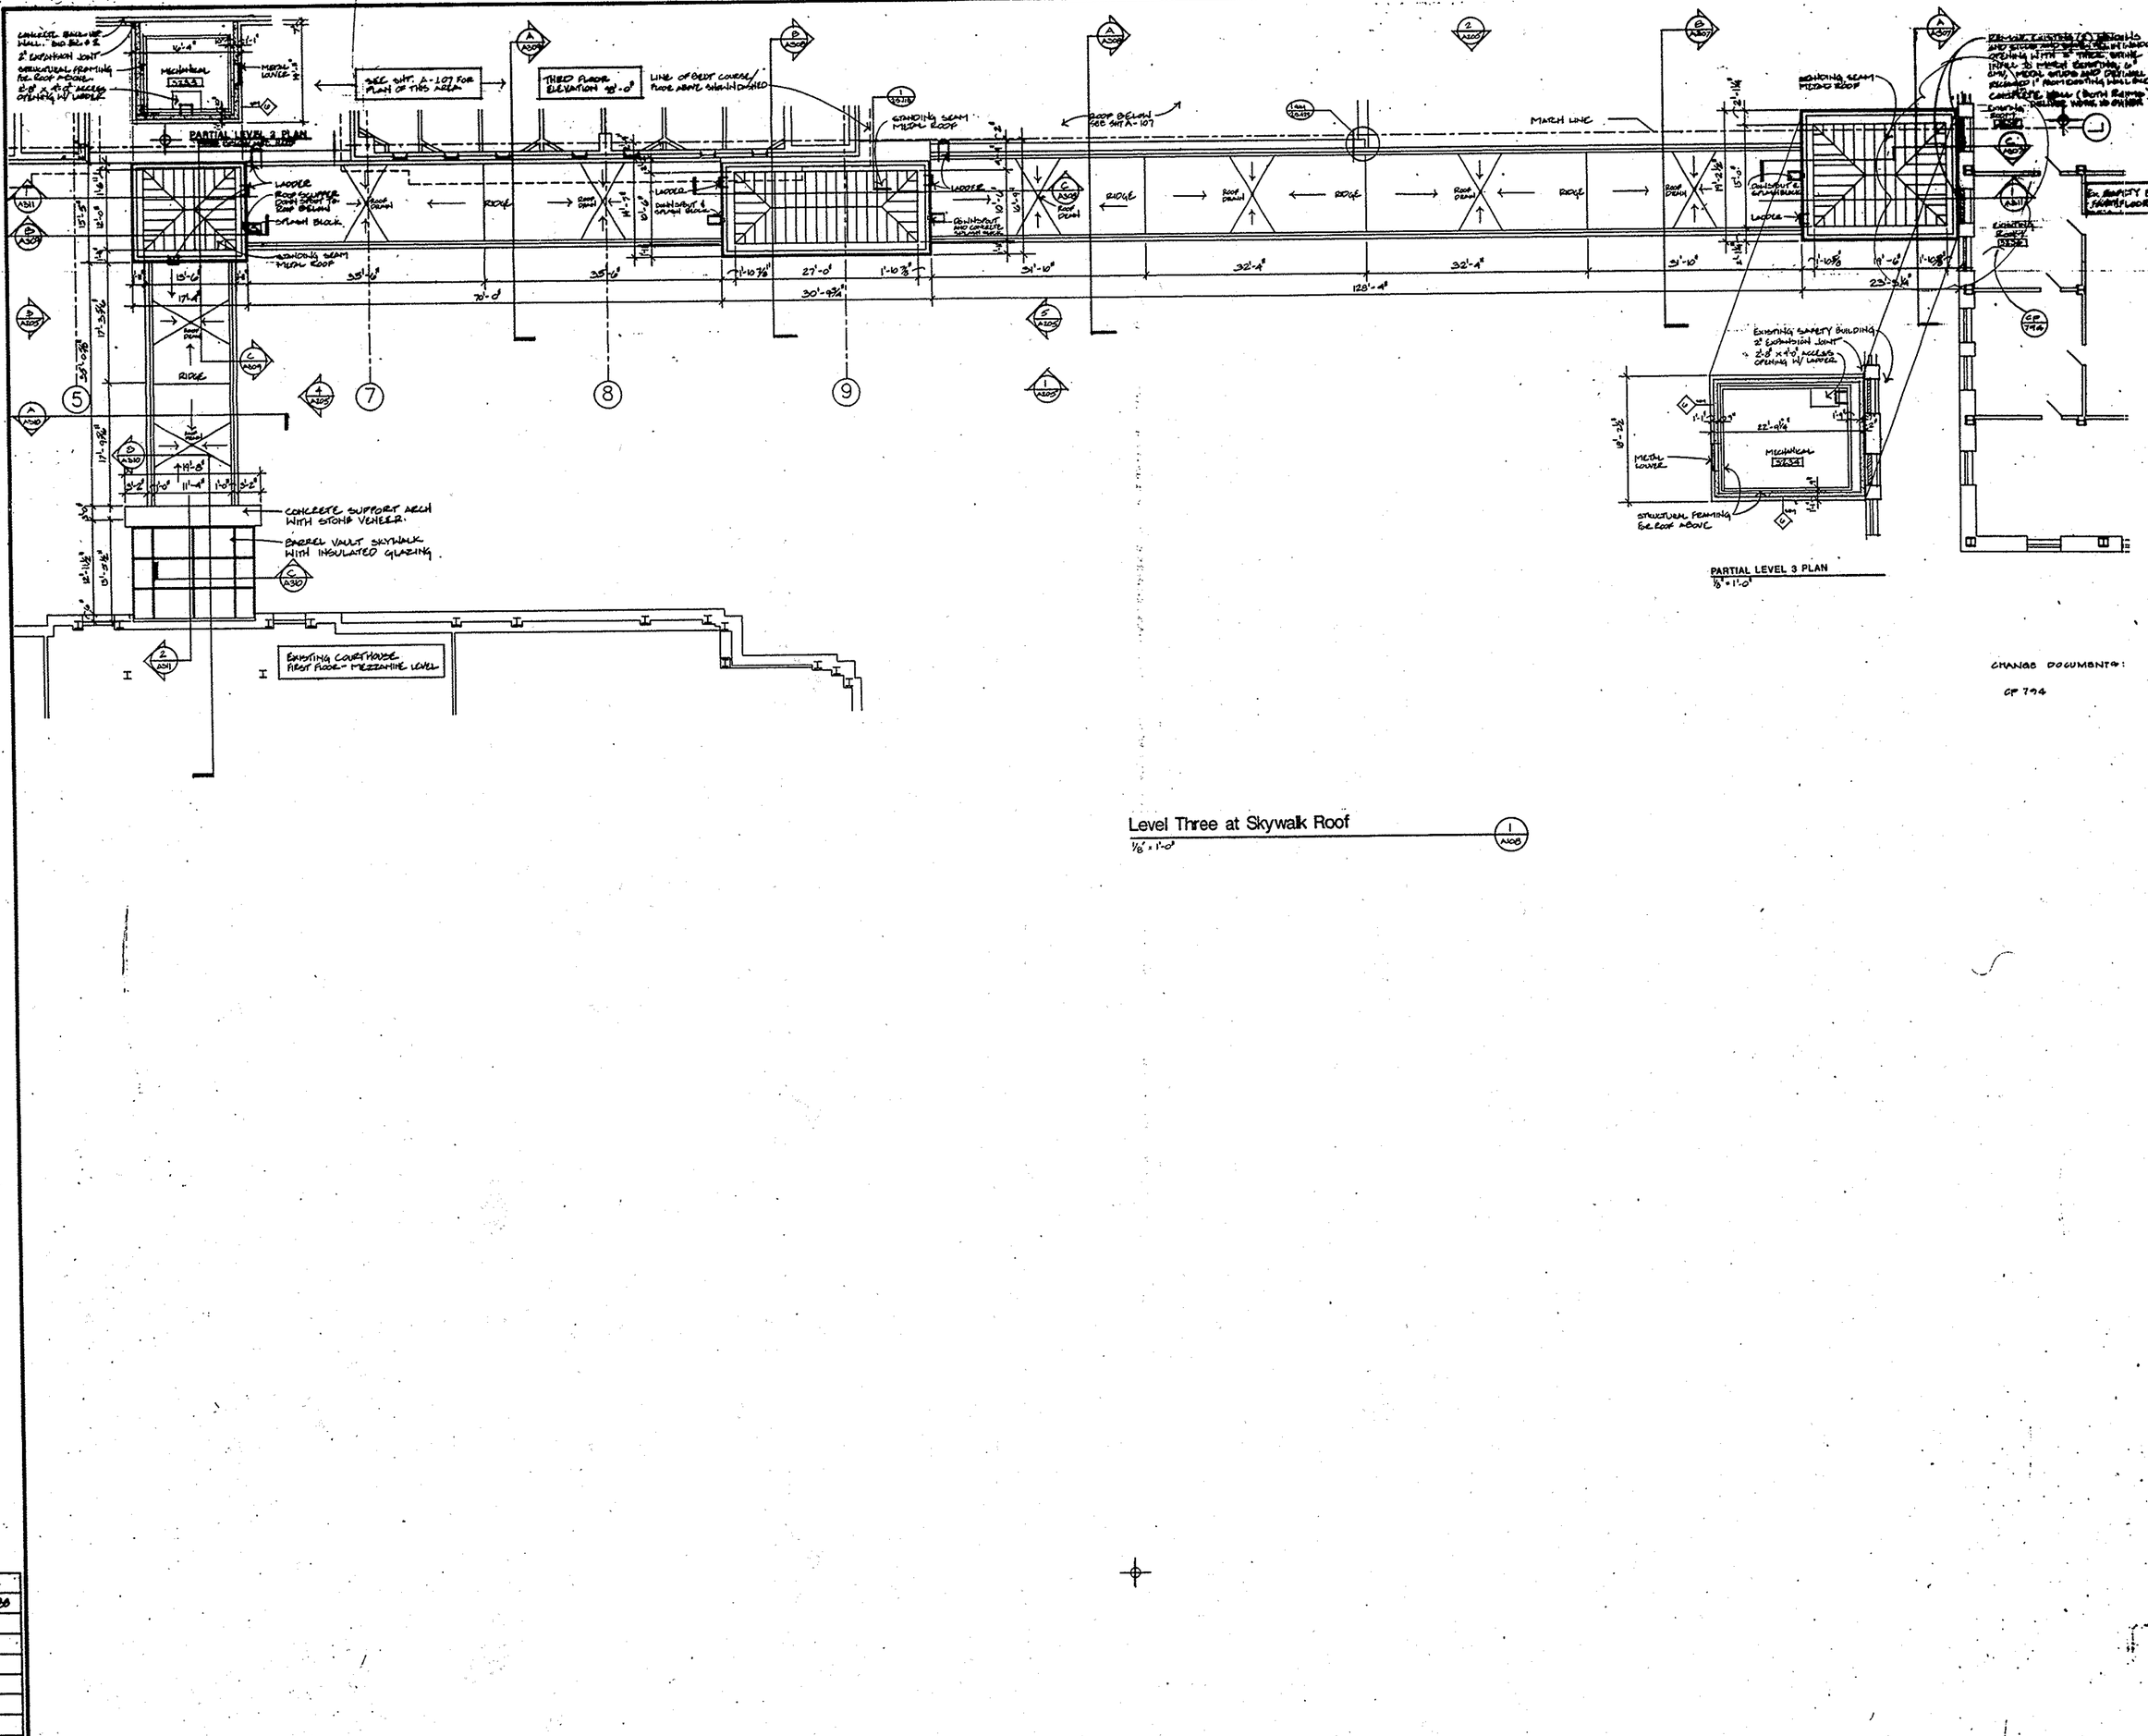

Joint Venture of: Design Group Kahler Slater Torphy Architects Architect Number 88003

Venture Architects

MILWAUKEE COUNTY DEPARTMENT OF PUBLIC WORKS
PROFESSIONAL SERVICES DIVISION
COURTHOUSE ANNEX 247 NORTH 10TH STREET MILWAUKEE, WISCONSIN 53233

REVISIONS

SHEET NO. A-108
PROJECT NO. 01-4436
PROJECT TITLE: MILWAUKEE COUNTY JAIL & CRIMINAL JUSTICE FACILITY Milwaukee Wisconsin
SHEET DESCRIPTION: LEVEL THREE AT SKYWALK ROOF
SCALE: 1/8" = 1'-0"
DATE: AUGUST 6, 1990
DRAWN BY:
CHECKED BY:
FILE NO.

SHEET NO. A-117	PROJECT NO. 01-4436	SHEET DESCRIPTION PENTHOUSE & ROOF PLAN	SCALE: 1/8" = 1'-0"	DRAWN BY:
		PROJECT TITLE: MILWAUKEE COUNTY JAIL & CRIMINAL JUSTICE FACILITY Milwaukee Wisconsin	DATE: AUGUST 6, 1990	CHECKED BY:

REVISIONS

As-Built

MILWAUKEE COUNTY DEPARTMENT OF PUBLIC WORKS
PROFESSIONAL SERVICES DIVISION
COURTHOUSE ANNEX 907 NORTH 10TH STREET MILWAUKEE, WISCONSIN 53233

Ventura Architects

Joint Venture of:
tho Zimmerman Design Group
Kahler Slater Torphy Architects
Architect Number 88003

NORTH

CHANGE DOCUMENTS:
CP 717
CP 715
CP 914
RFI 09-072

NOTE "A" RE FLOOR OPENINGS TO SHAFT:
EXACT SIZE OF OPENING IS TO BE COORDINATED WITH MECHANICAL CONTRACTORS DRAWINGS. OPENING IS TO BE COVERED WITH CONCRETE SLAB (2 HR. RATED). OPENINGS AT TOP OF SHAFTS NOTED ARE TO BE PROTECTED AS PER SPECIFICATION SEC. 11145, IN ACCORDANCE WITH

ADDENDUM 4 PAGE 4a:
1. Rem no. 00902 - At each railing add: "At steel railing just West of the stair tower provide a removable section of railing 9'-0" wide. Refer to 1/27.012 for removable railing bracket details.

B.U. ROOFING TAPERED RIGID INSUL. PER DET.

LOUVER HOUSING BY HVAC

OVERFLOW SCUPPER

CANT STRIP

CONC. COPING

TOP OF SHAFT "A" SEE NOTE "A"

SHIP LADDER

PREFAB. DECK OVER SPOUT

PREFAB. DECK OVER MACH. ROOM EL. 1044'-0"

STL. RAILING 30'-0"

SEE SHEET A354 FOR HOISTWAY DIM.

TRANSUNIT MR. CLG.

MECH. ROOM ROOM 20003

PLENUM ROOM 20004

PENTHOUSE 20005

ELEV. MACH. ROOM 20006

PIT 20007

ELEV. MACH. ROOM 20008

PLUMBING VENT

SEE SHEET A-354 FOR HOISTWAY DIM.

4" TRUE DOWN

(4) CHUTES DOWN

7'-8"

8'-4"

5'-5"

8'-7"

5'-0"

3'-0"

2'-0"

1'-0"

1'-7"

1'-8"

1'-10"

1'-11"

















103'-6"

44'-0"

28'-1"

11 PANELS @ 8'-8" = 95'-4"

RFI 09-072

17'-11"

35'-2"

130'-11"

40'-10"

13 PANELS @ 8'-8" = 112'-8"

27'-8"

91'-1½" (NOT TO SCALE)

CONC. STEP

CONC. STRIP

ADD 4 PG. 4a STRIP / DETAIL 1/27.012

COOLING TOWER SUPPORT STRAINING (STRUCTRL)

WALKWAY TREADS WHERE OCCUR BEFORE PLANKING

24'-9"

24'-5"

47'-0"

44'-0"

8'-8"

8'-2"

6'-2"

6'-8"








































E-7-6

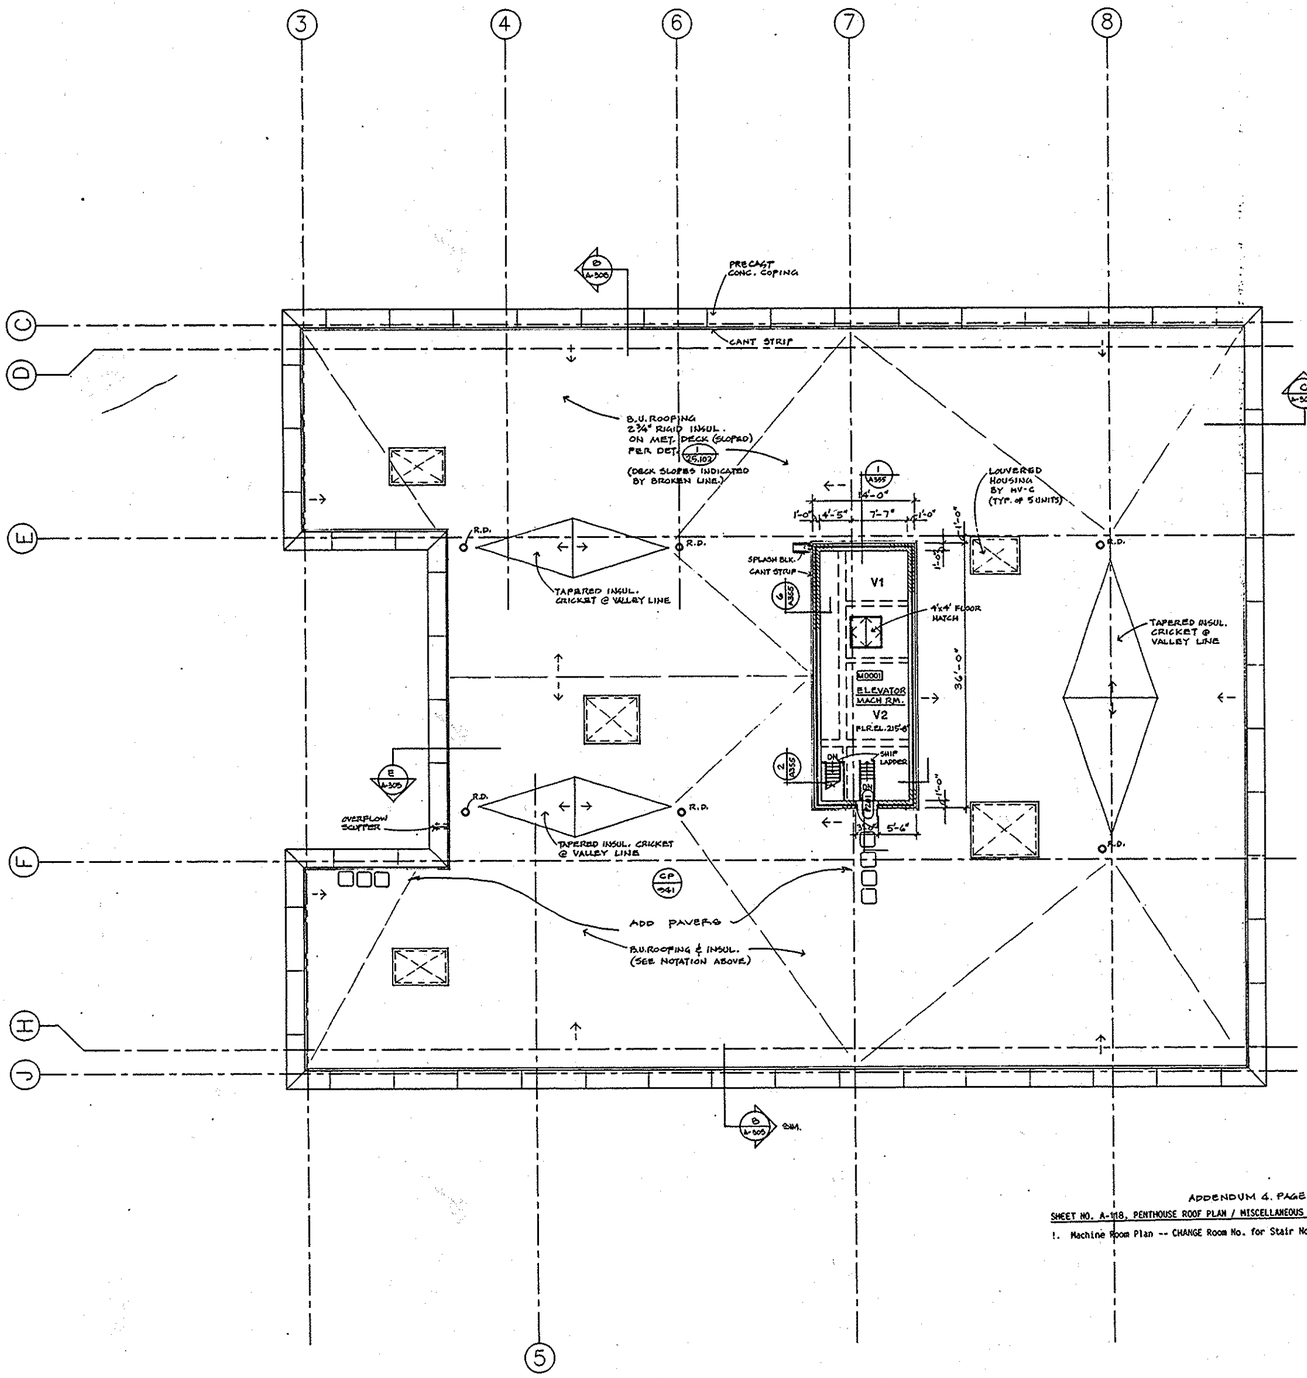

Penthouse Roof Plan & Upper Penthouse Floor Plan

1/8" = 1'-0"

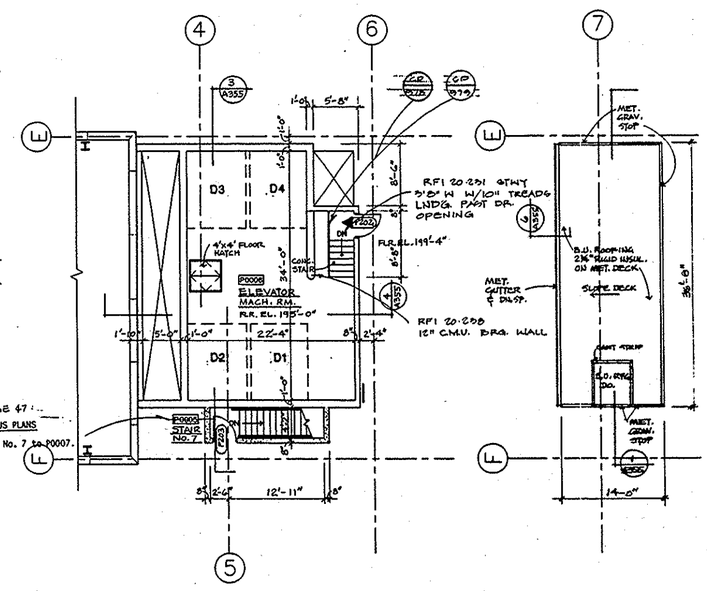

Machine Room Plan

Inmate Elevators D1 thru D4

1/8" = 1'-0"

Roof Plan - Upper Penthouse

Visit Elevators V1, V2

1/8" = 1'-0"

CHANGE DOCUMENTS:

CP 941 CP 979
CP 978 CP 941

RFI 20-231
20-238

ADDENDUM 2 PAGE 54:

A-118 PENTHOUSE ROOF PLAN

1. ADD the following NOTE: Four (4) additional louvered housings will be provided by Contract 7. Framed openings in roof shall be provided by Contract 5. Refer to HVAC drawings for locations.

ADDENDUM 4. PAGE 47:

SHEET NO. A-118, PENTHOUSE ROOF PLAN / MISCELLANEOUS PLANS

1. Machine Room Plan -- CHANGE Room No. for Stair No. 7 to P0007.

NORTH

Joint Venture of:
the Zimmerman Design Group
Kahler Slater Torphy Architects
Architect Number 88003

Venture Architects

MILWAUKEE COUNTY DEPARTMENT OF PUBLIC WORKS
PROFESSIONAL SERVICES DIVISION
COURTHOUSE ANNEX 907 NORTH 10TH STREET MILWAUKEE, WISCONSIN 53233

REVISIONS: AS-BUILT

DRAWN BY

CHECKED BY

SCALE: 1/8" = 1'-0"

DATE: AUGUST 6, 1990

PROJECT TITLE: MILWAUKEE COUNTY JAIL & CRIMINAL JUSTICE FACILITY Milwaukee Wisconsin

SHEET DESCRIPTION: PENTHOUSE ROOF PLAN/MISC. PLANS

PROJECT NO. 81-4436

SHEET NO. A-118

FILE NO.

A-118

E-7-6

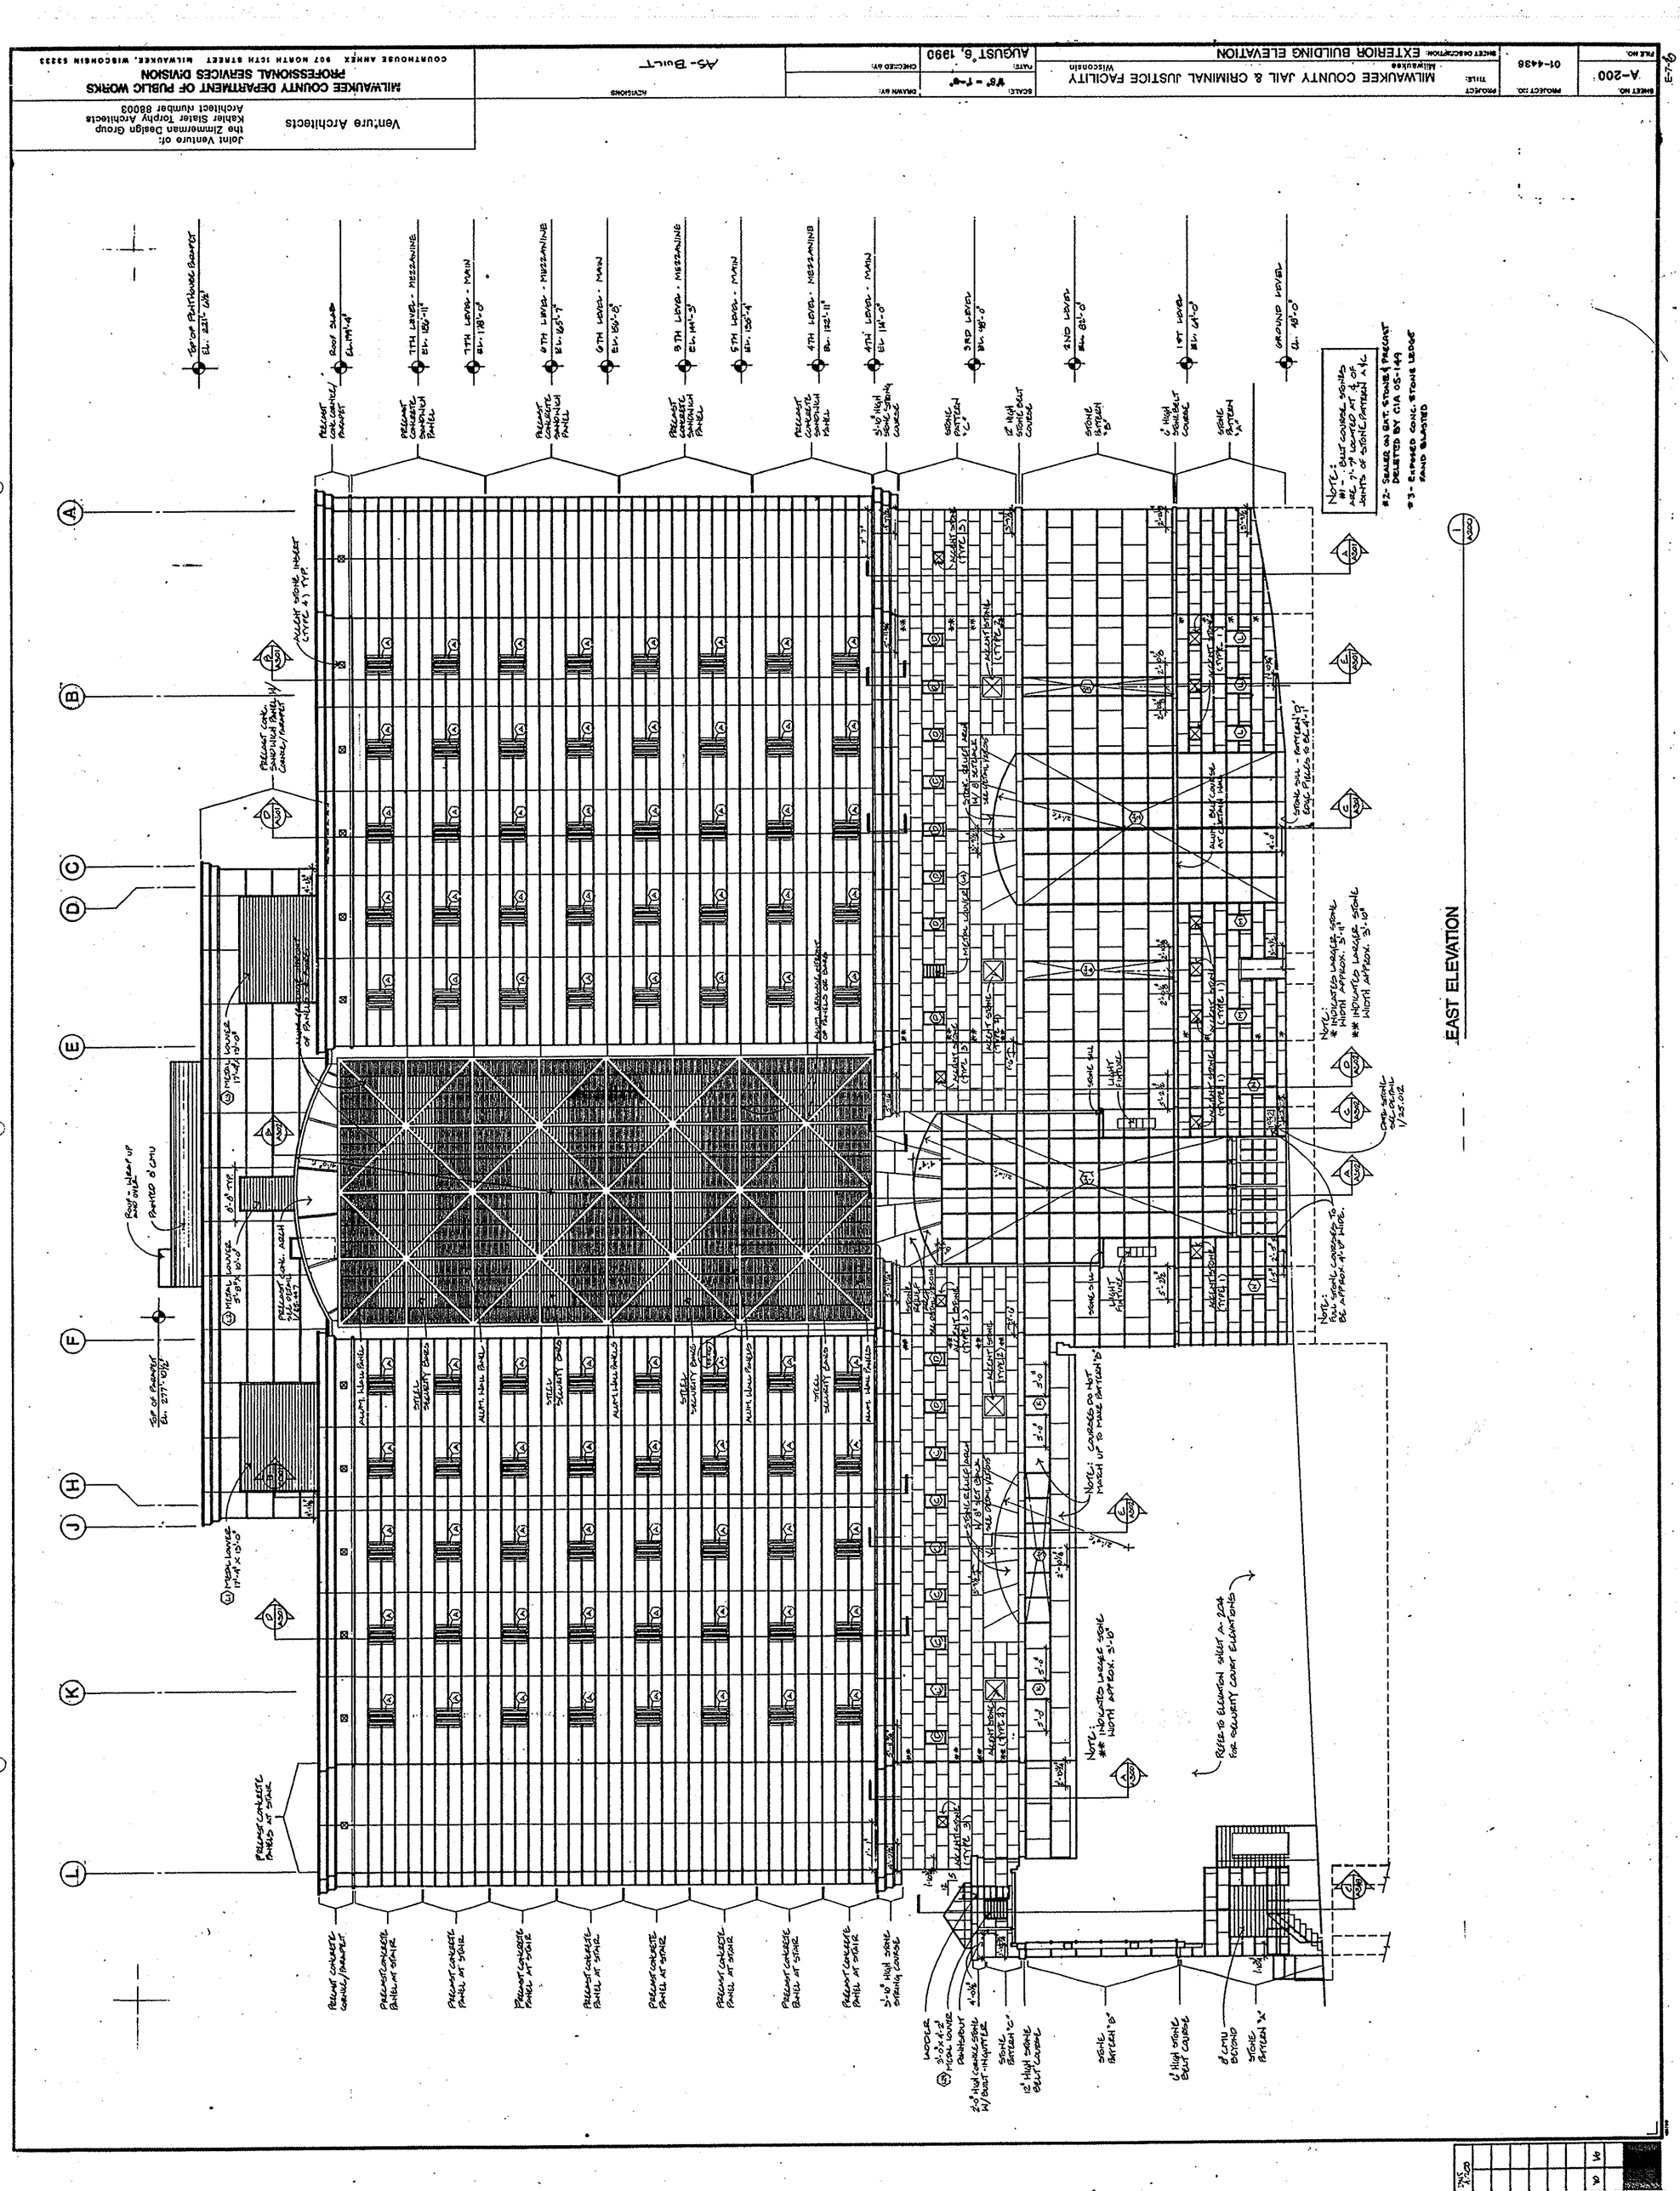

EAST ELEVATION
Venture Architects
Joint Venture of:
the Zimmerman Design Group
Kahler Slater Torphy Architects
Architect Number 88003
MILWAUKEE COUNTY DEPARTMENT OF PUBLIC WORKS
PROFESSIONAL SERVICES DIVISION
COURTHOUSE ANNEX 907 NORTH 10TH STREET MILWAUKEE, WISCONSIN 53233
AS-BUILT
AUGUST 6, 1990
EXTERIOR BUILDING ELEVATION
MILWAUKEE COUNTY JAIL & CRIMINAL JUSTICE FACILITY
Milwaukee Wisconsin
01-4436
A-200

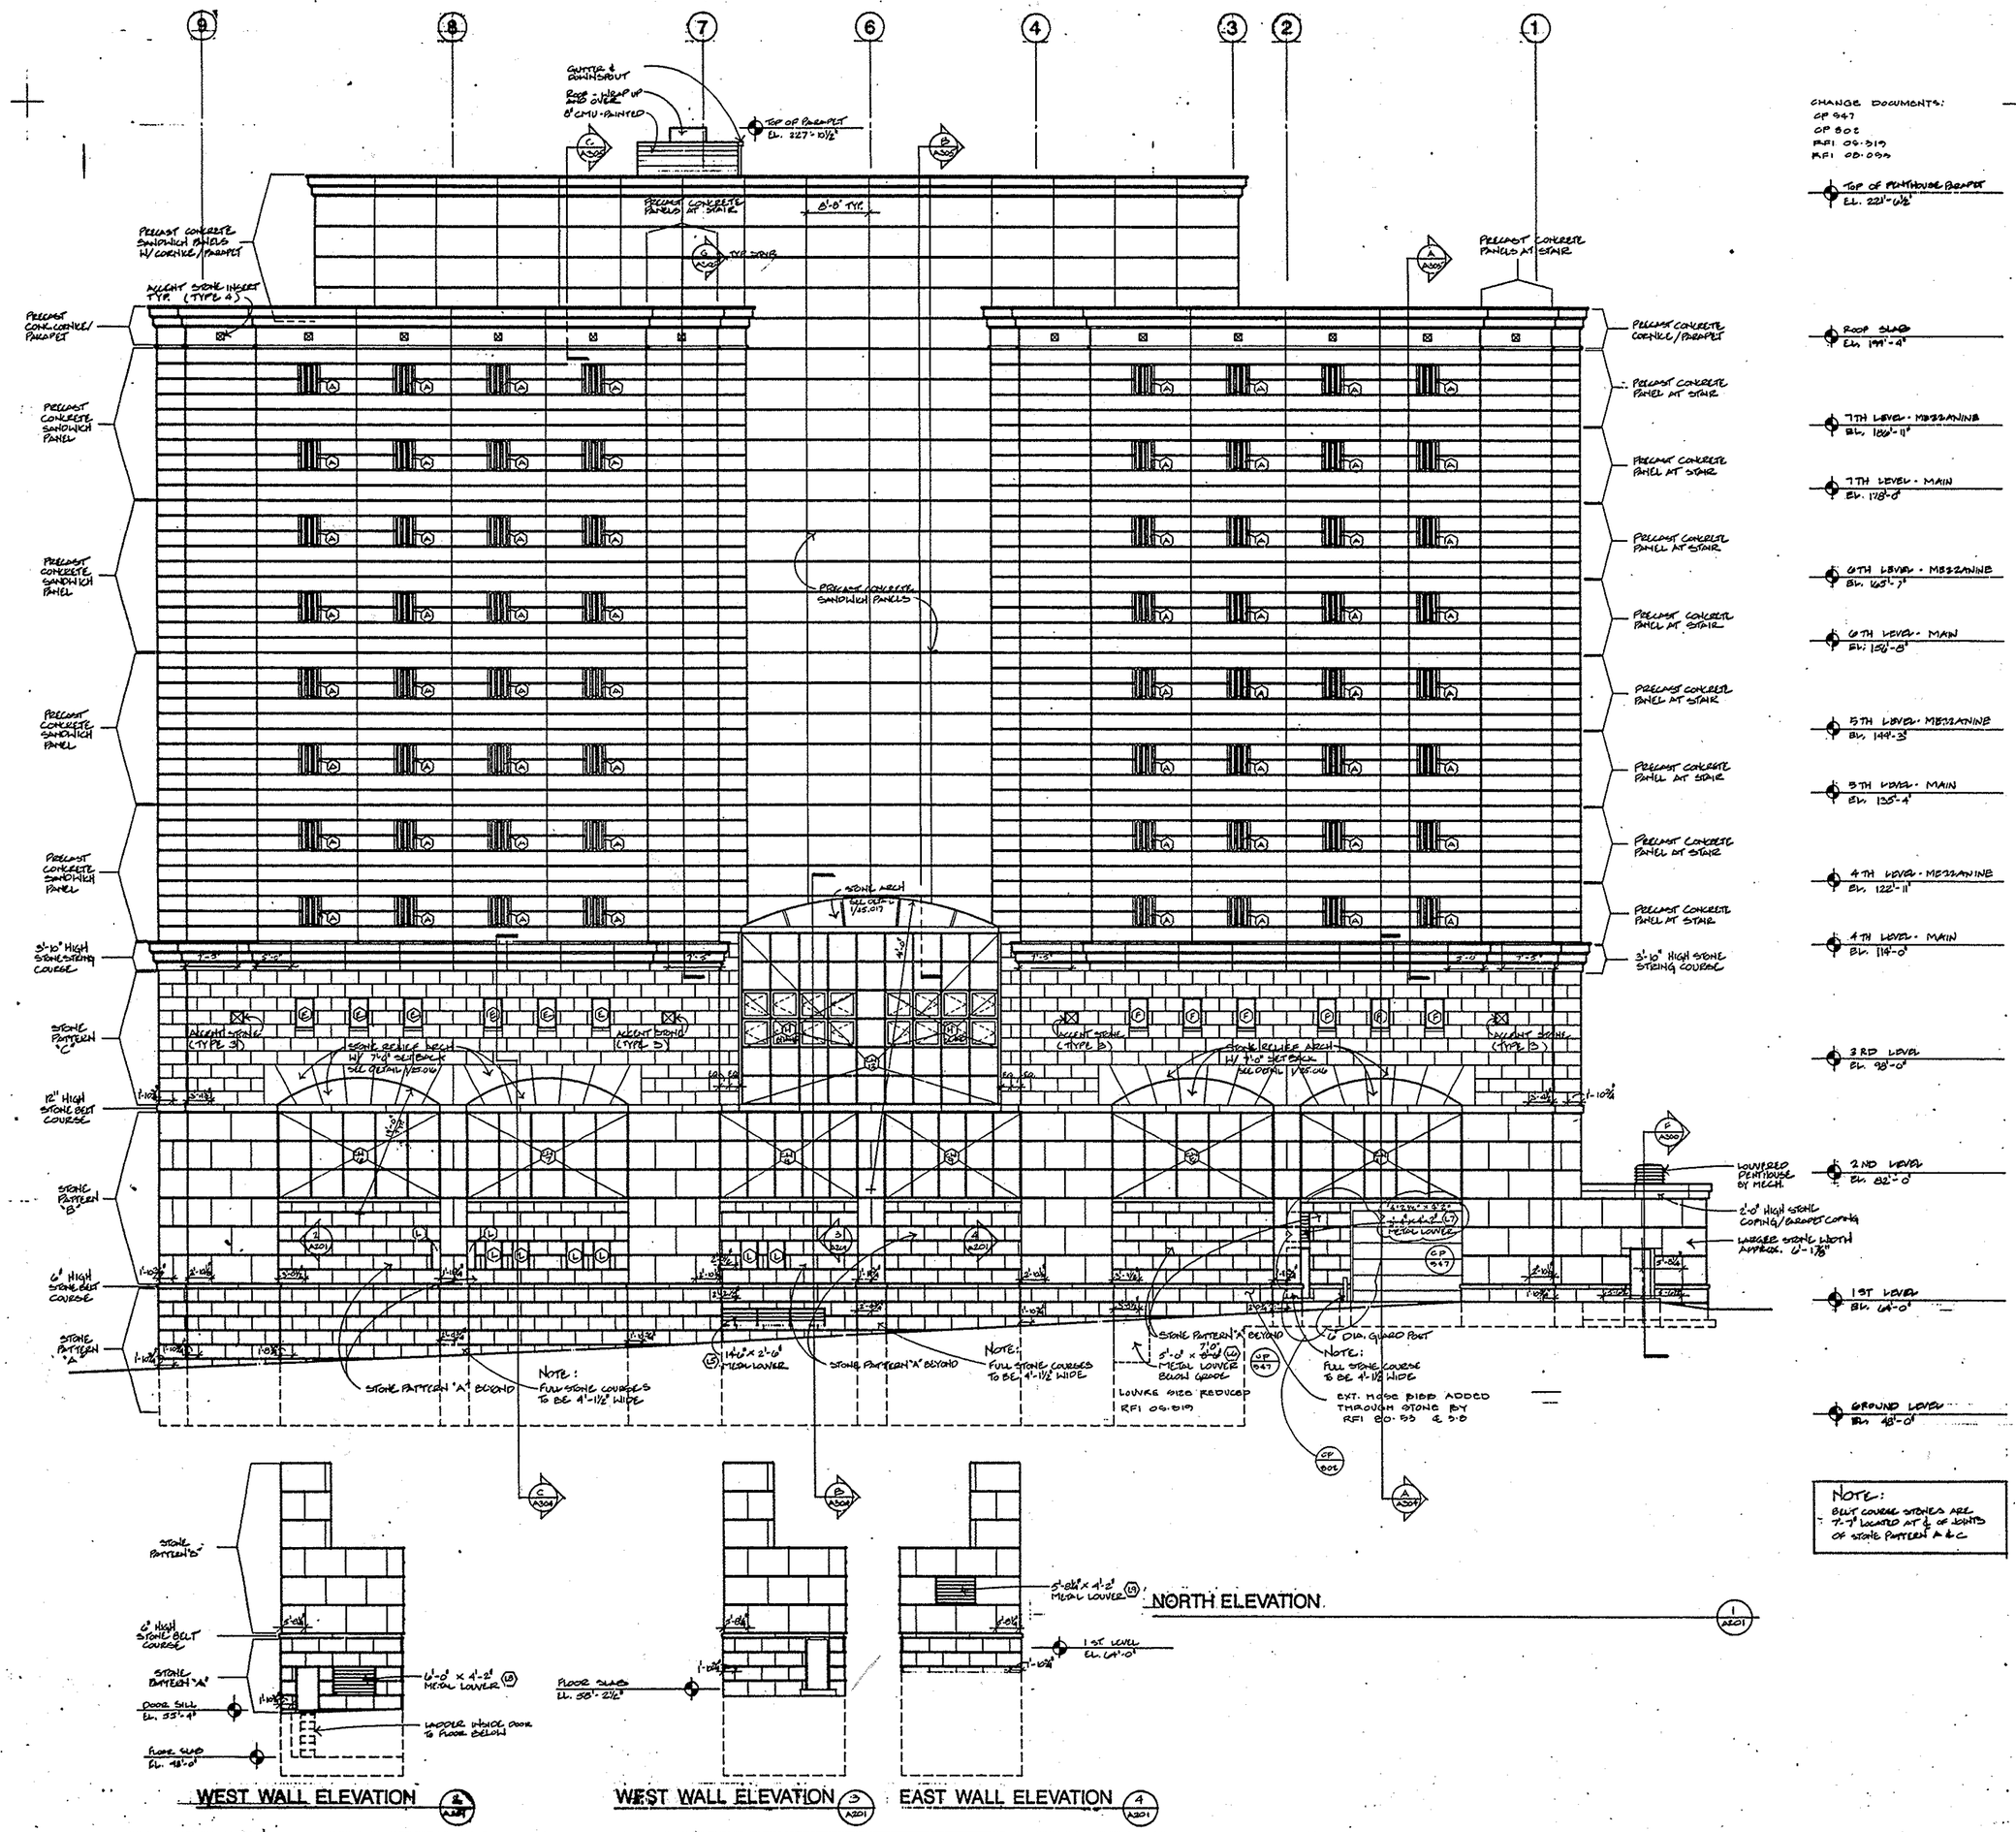

CHANGE DOCUMENTS:
CP 947
CP 802
RFI 09-319
RFI 08-093

Joint Venture of:
the Zimmerman Design Group
Kahler Slater Torphy Architects
Architect Number 88003

Venture Architects

MILWAUKEE COUNTY DEPARTMENT OF PUBLIC WORKS
PROFESSIONAL SERVICES DIVISION
COURTHOUSE ANNEX 821 NORTH 10TH STREET MILWAUKEE, WISCONSIN 53233

REVISIONS

AS-BUILT

SCALE: 1/8" = 1'-0"
DRAWN BY:
CHECKED BY:
DATE: AUGUST 6, 1990

PROJECT TITLE: MILWAUKEE COUNTY JAIL & CRIMINAL JUSTICE FACILITY
Milwaukee Wisconsin
SHEET DESCRIPTION: EXTERIOR BUILDING ELEVATION

PROJECT NO. 01-4436
SHEET NO. A-201
FILE NO.

E-7-6

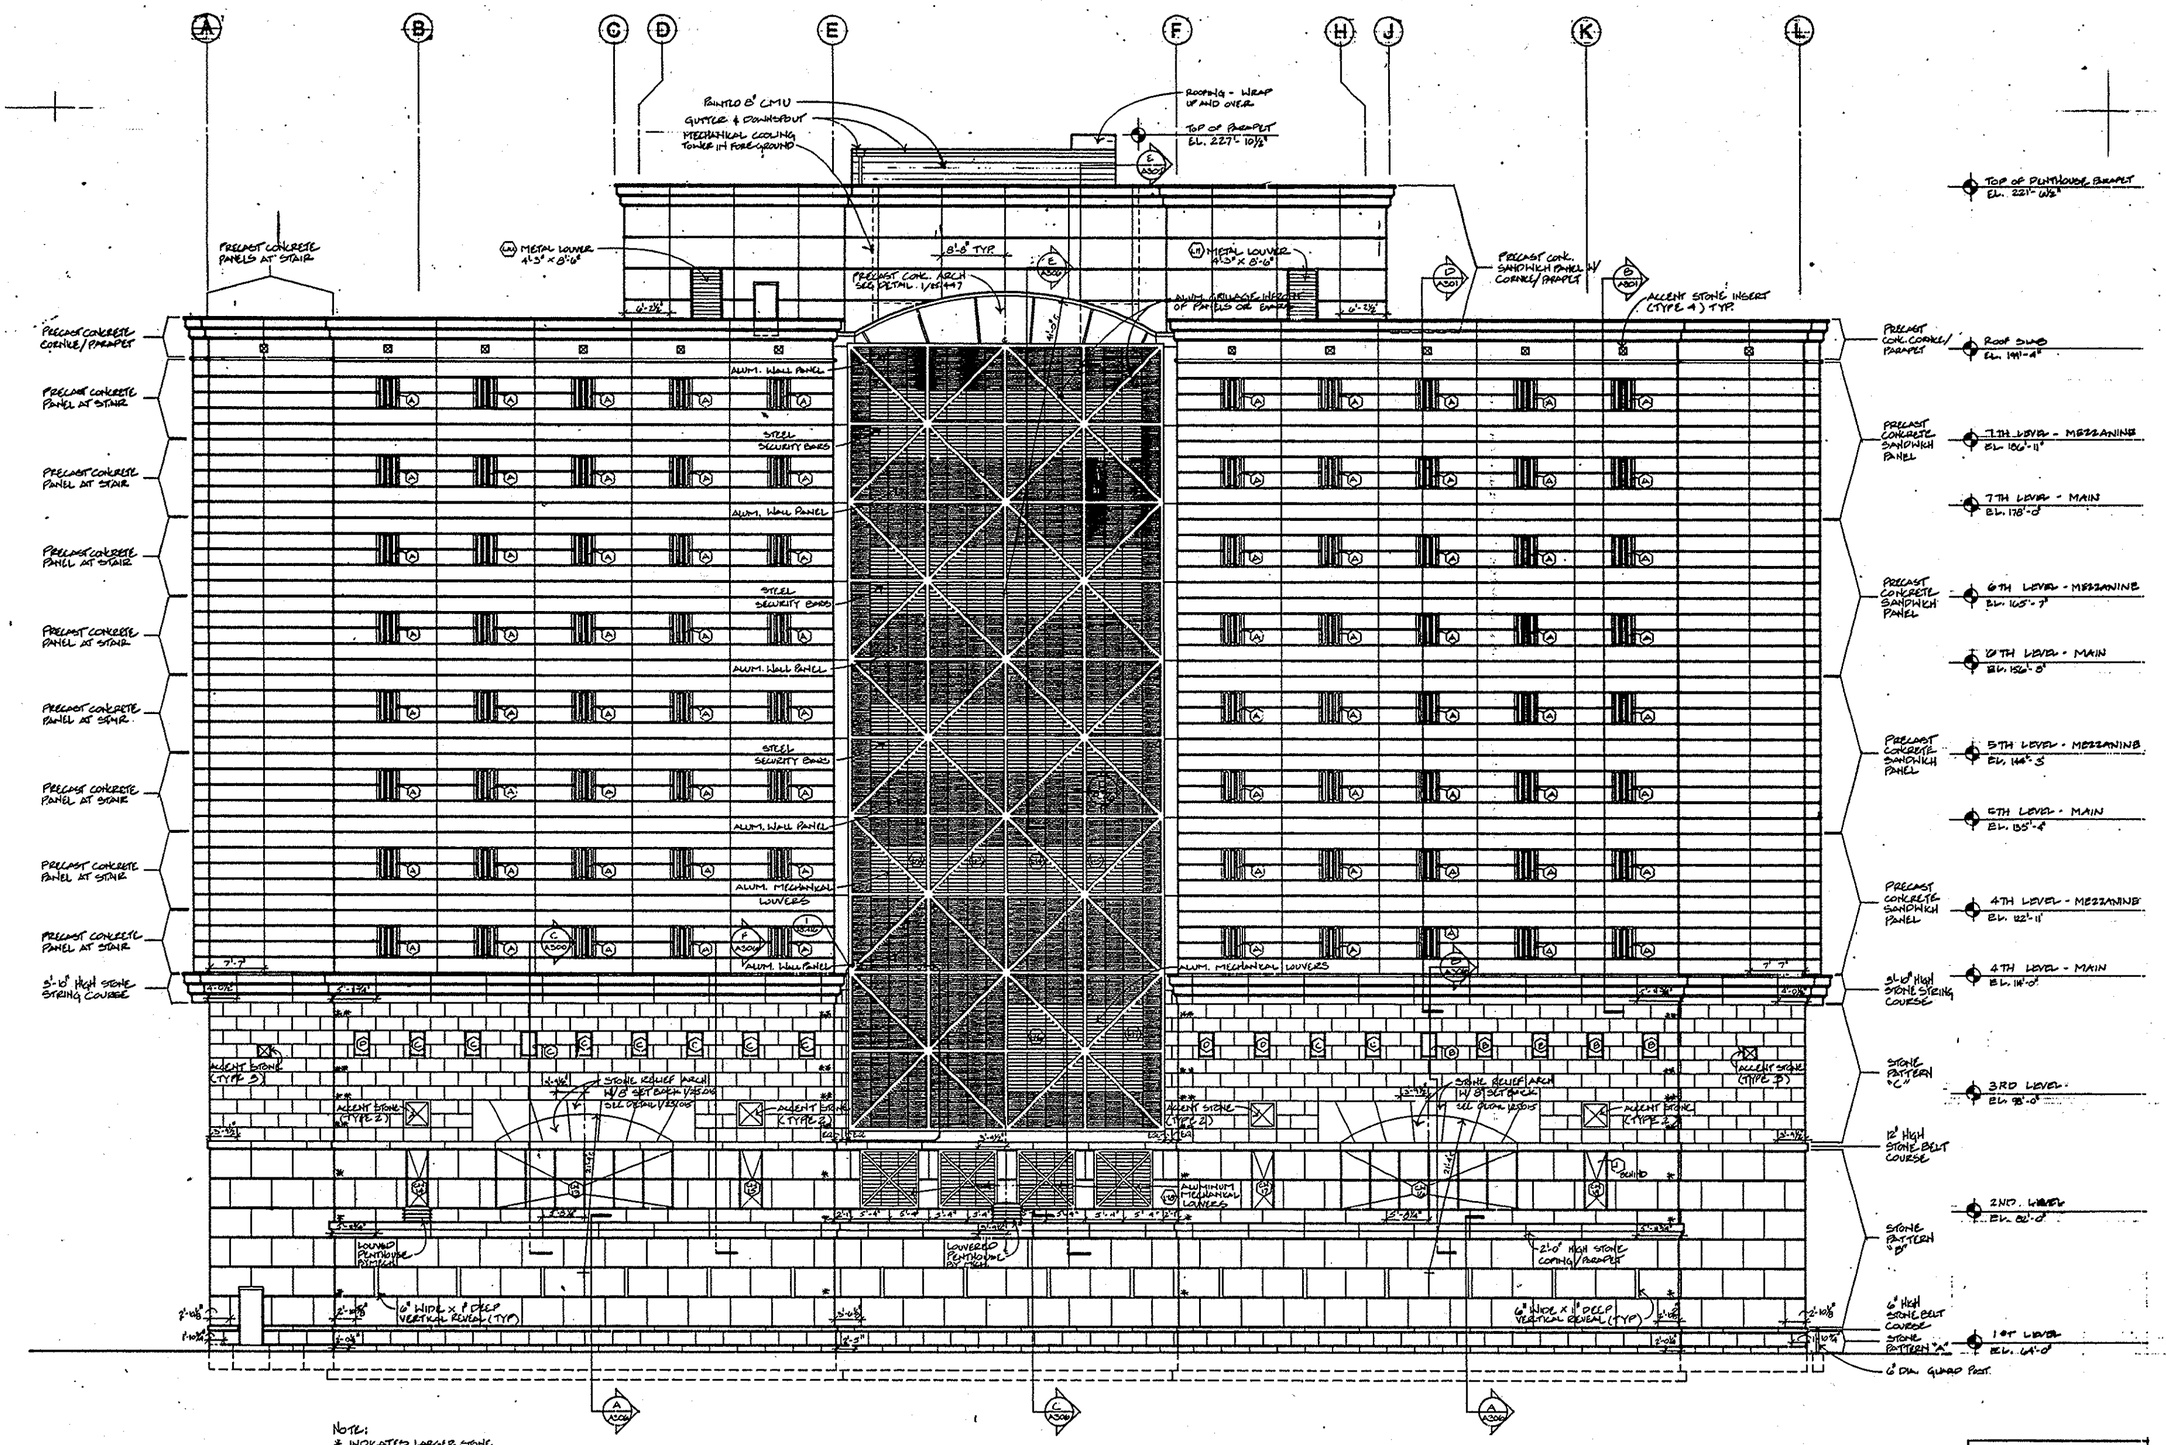

NOTE:
* INDICATES LARGER STONE WIDTH APPROX. 5'-8 3/4"
** INDICATES LARGER STONE WIDTH APPROX. 3'-0"

NOTE:
BELT COURSE STONES ARE 7'-7" LOCATED AT ¼ OF JOINTS OF STONE PATTERN A & C

WEST ELEVATION 1/A202

Joint Venture of:
The Zimmerman Design Group
Kahler Slater Torphy Architects
Architect Number 98003

Venture Architects

MILWAUKEE COUNTY DEPARTMENT OF PUBLIC WORKS
PROFESSIONAL SERVICES DIVISION
COURTHOUSE ANNEX 807 NORTH 16TH STREET MILWAUKEE, WISCONSIN 53233

REVISIONS

AS-BUILT

DRAWN BY:
CHECKED BY:
SCALE: 1/8" = 1'-0"
DATE: AUGUST 9, 1990

PROJECT TITLE: MILWAUKEE COUNTY JAIL & CRIMINAL JUSTICE FACILITY Wisconsin
SHEET DESCRIPTION: EXTERIOR ELEVATION

PROJECT NO. 01-4436
SHEET NO. A-202
FILE NO.

E-7-90

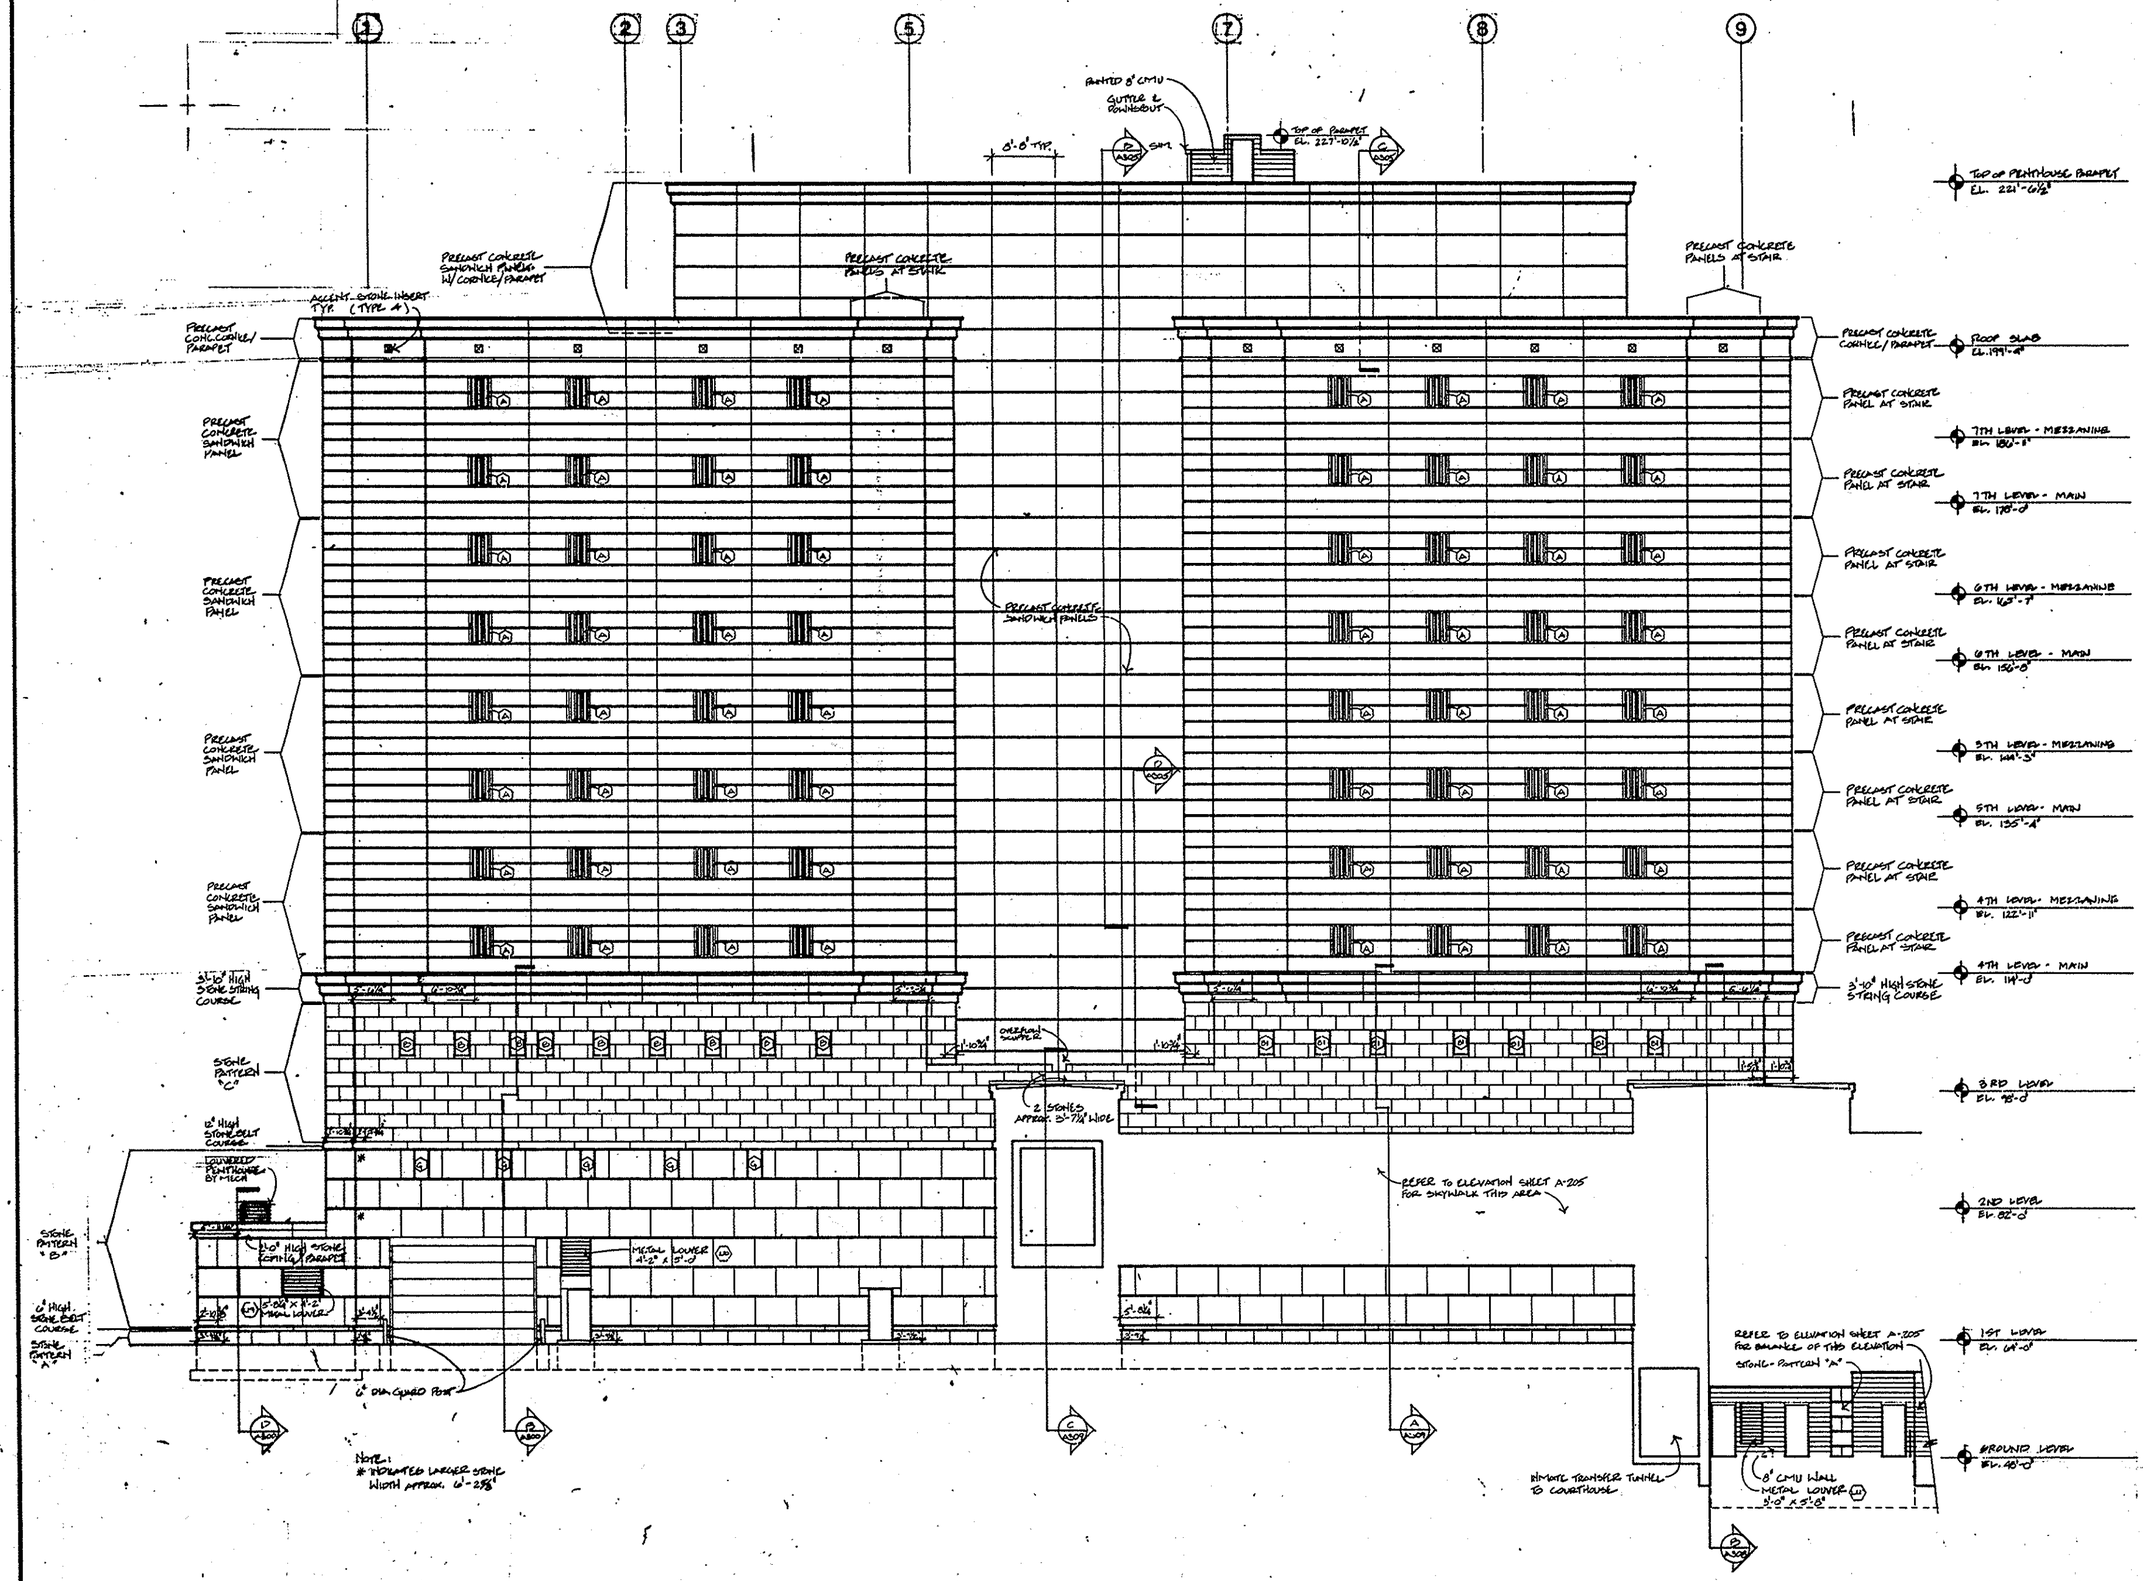

SOUTH ELEVATION

Venture Architects

Joint Venture of:
the Zimmerman Design Group
Kahler Slater Torphy Architects
Architect Number 88003

MILWAUKEE COUNTY DEPARTMENT OF PUBLIC WORKS
PROFESSIONAL SERVICES DIVISION
COURTHOUSE ANNEX 907 NORTH 10TH STREET MILWAUKEE, WISCONSIN 53233

REVISIONS

DRAWN BY:
CHECKED BY:
SCALE: 1/8" = 1'-0"
DATE: AUGUST 6, 1990

PROJECT TITLE: MILWAUKEE COUNTY JAIL & CRIMINAL JUSTICE FACILITY
Milwaukee Wisconsin
SHEET DESCRIPTION: EXTERIOR BUILDING ELEVATION

PROJECT NO. 01-4436
SHEET NO. A-203
FILE NO.

A-203

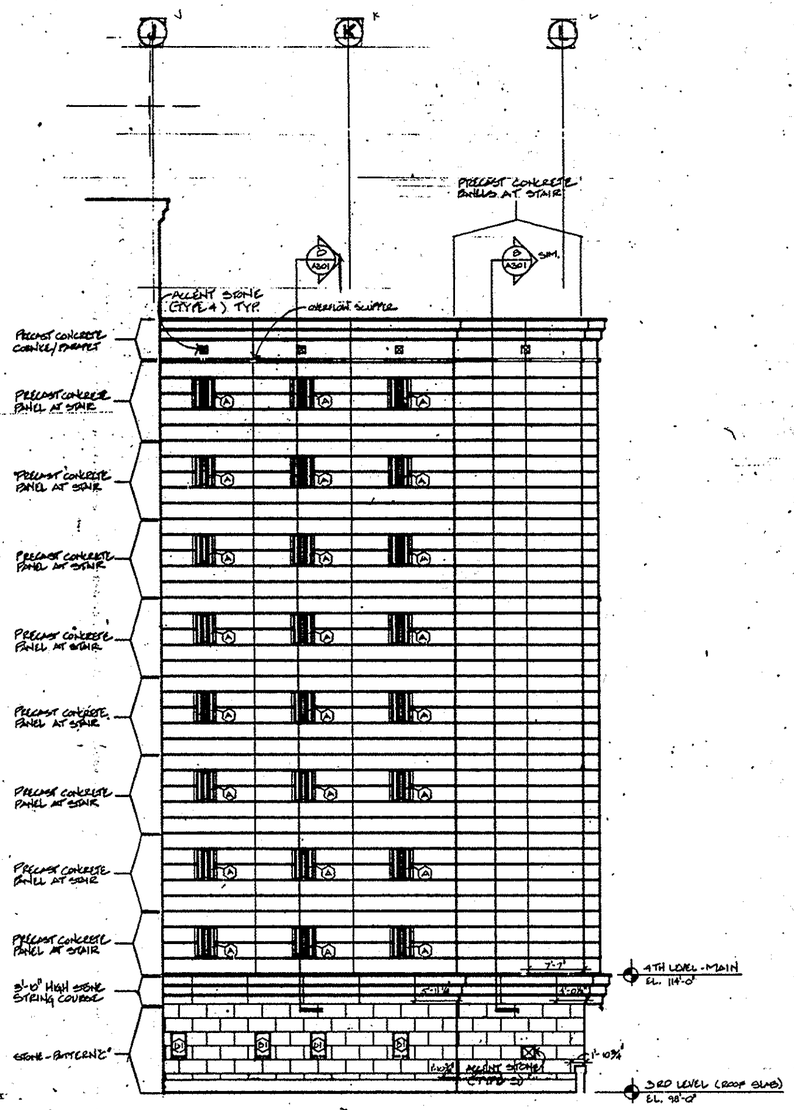

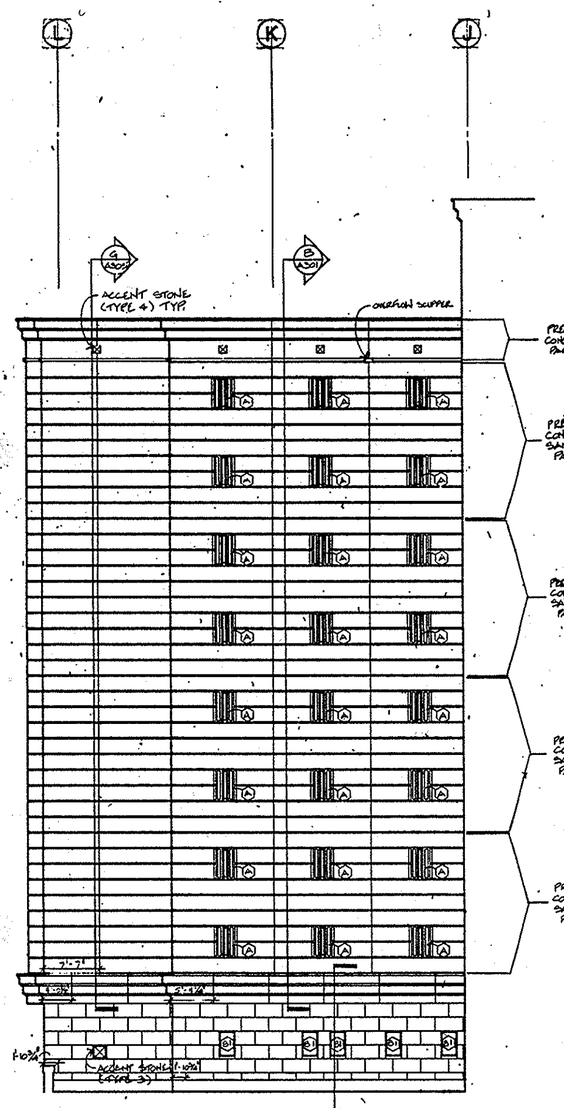

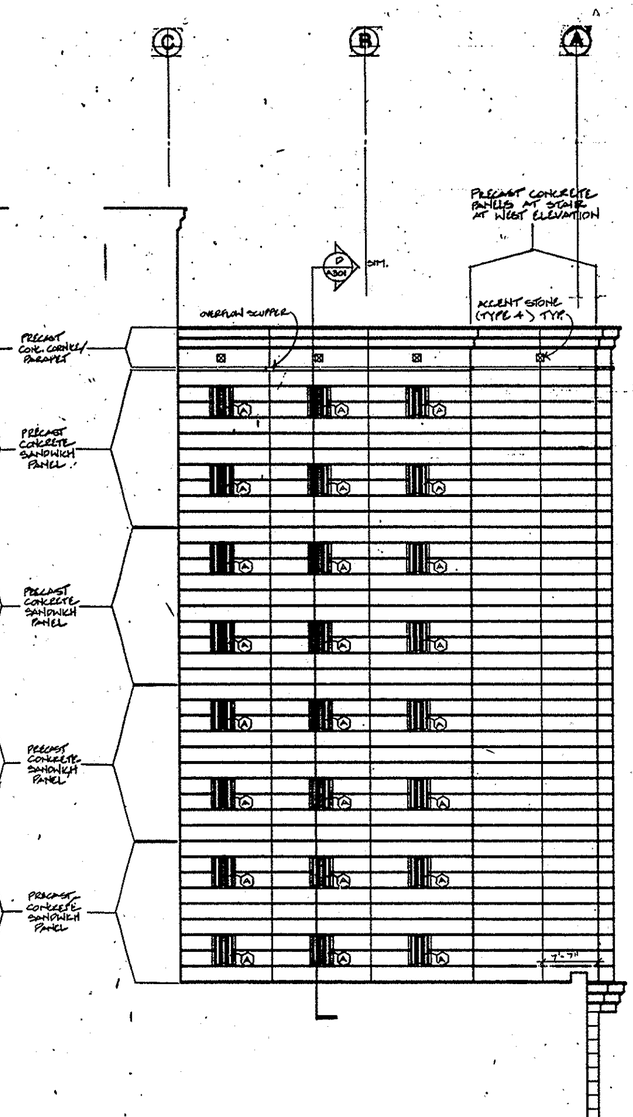

WEST ELEVATION

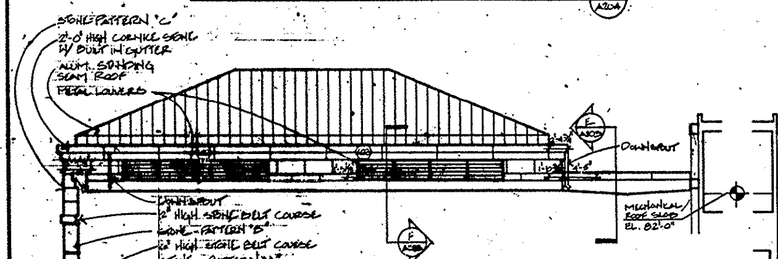

WEST ELEVATION

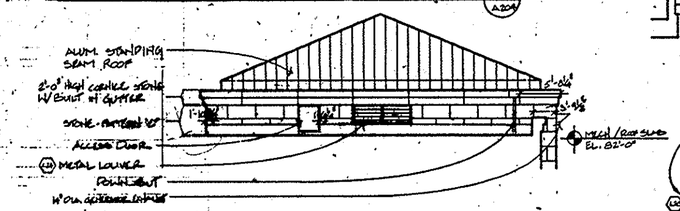

SOUTH ELEVATION

EAST ELEVATION

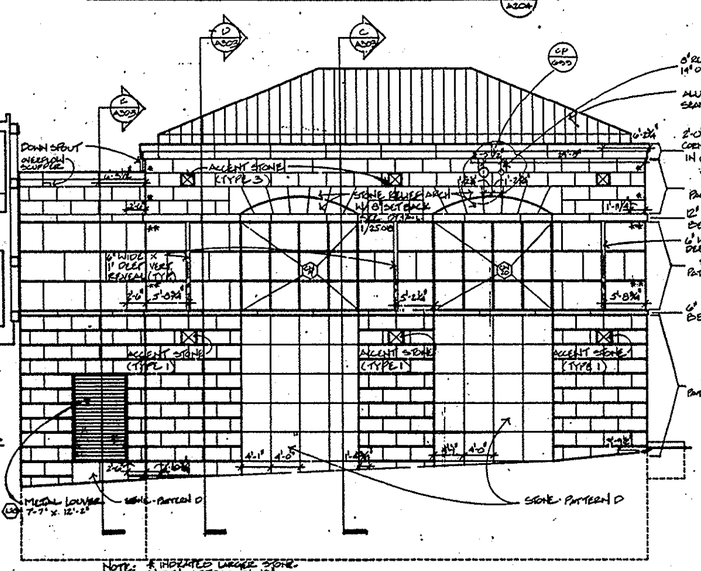

NOTE: 4 INDICATED LARGER STONE WIDTH APPROX. 5'-10"
8 INDICATED LARGER STONE WIDTH APPROX. 8'-0 3/4"

EAST ELEVATION

EAST ELEVATION
WEST ELEVATION OPPOSITE

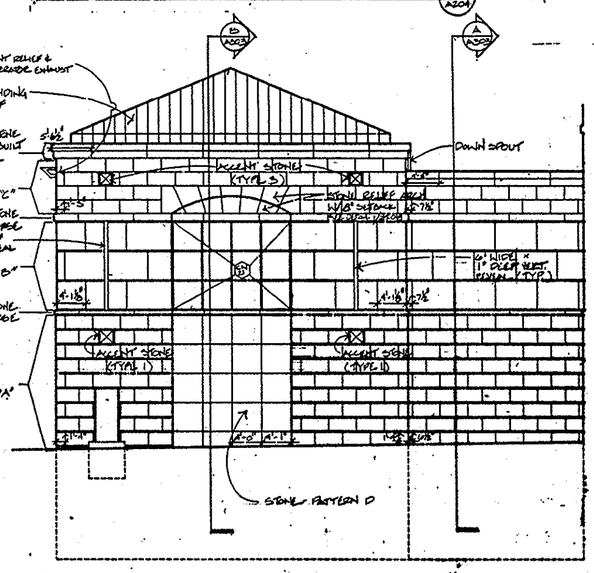

NORTH ELEVATION

COURTYARD ELEVATIONS

SECURITY

Joint Venture of:
the Zimmerman Design Group
Kahler Slater Torphy Architects
Architect Number 88003

Venture Architects

MILWAUKEE COUNTY DEPARTMENT OF PUBLIC WORKS
PROFESSIONAL SERVICES DIVISION
COURTHOUSE ANNEX: 821 NORTH 10TH STREET, MILWAUKEE, WISCONSIN 53233

REVISIONS

AS-BUILT

DRAWN BY:
CHECKED BY:
SCALE: 1/8" = 1'-0"
DATE: AUGUST 6, 1980

PROJECT TITLE
COUNTY JAIL & CRIMINAL JUSTICE FACILITY
Wisconsin

A-204

79-204

E-7-6

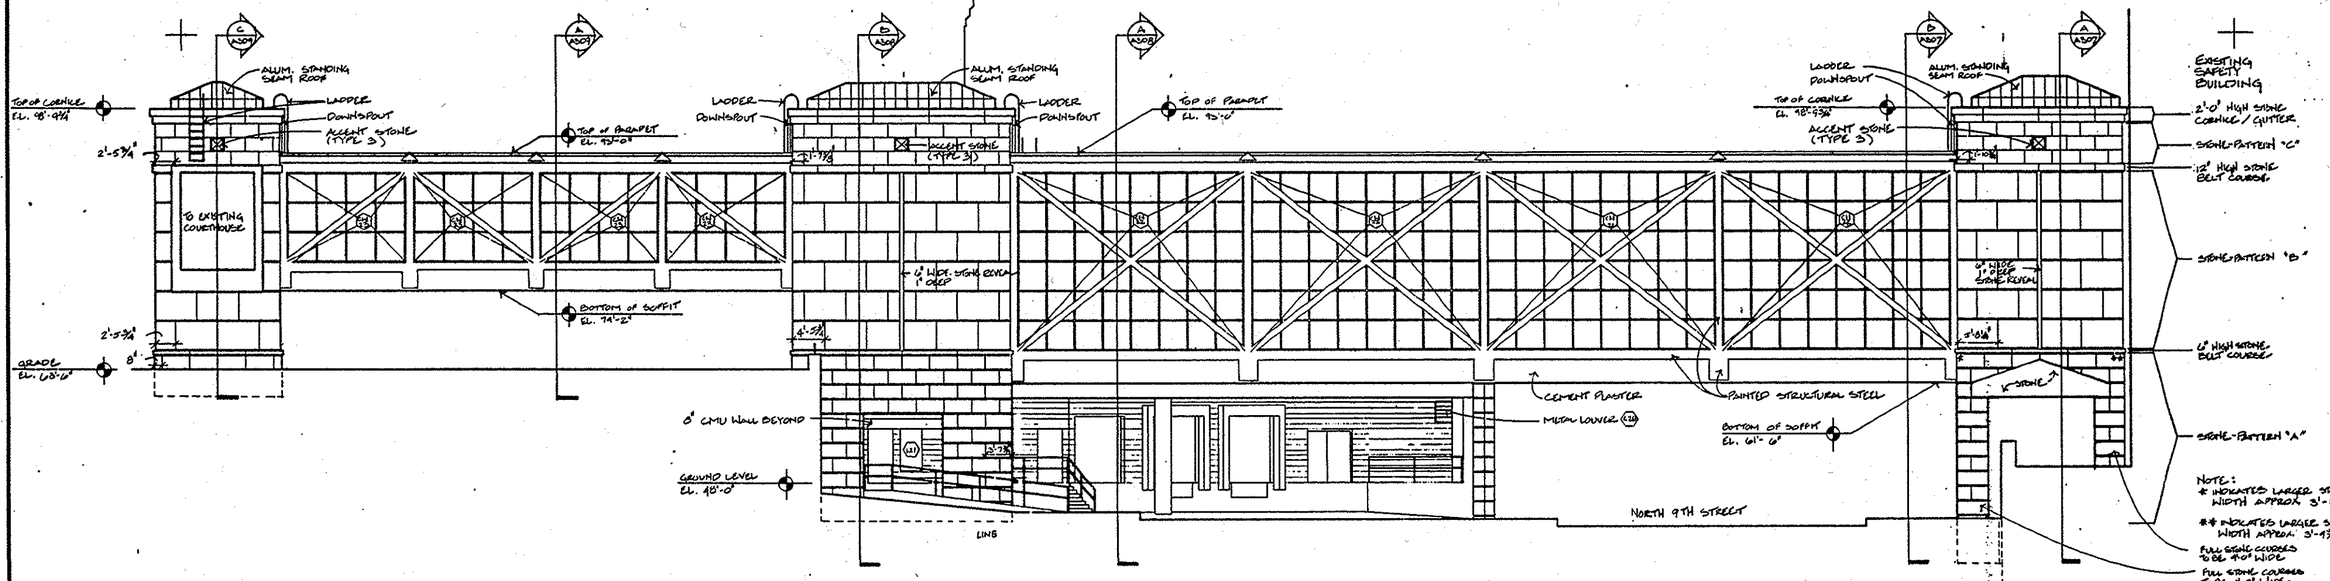

SOUTH SKYWALK ELEVATION — 1 / A205

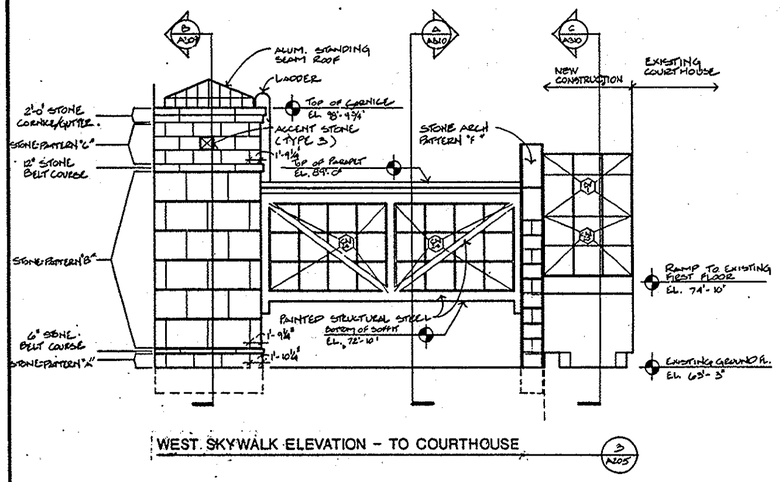

WEST SKYWALK ELEVATION – TO COURTHOUSE — 3 / A205

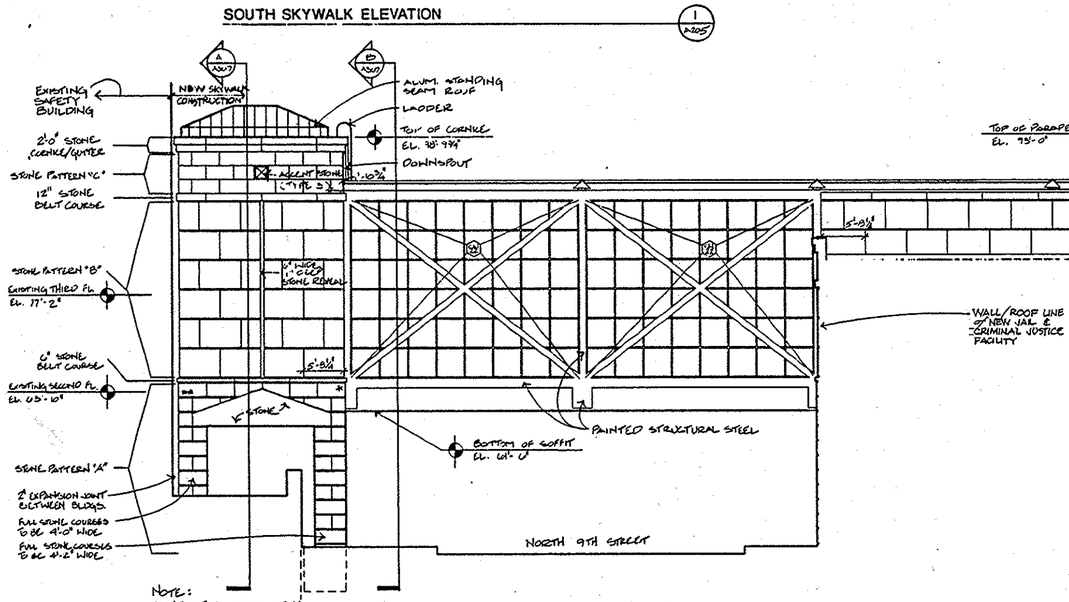

NORTH SKYWALK ELEVATION — 2 / A205

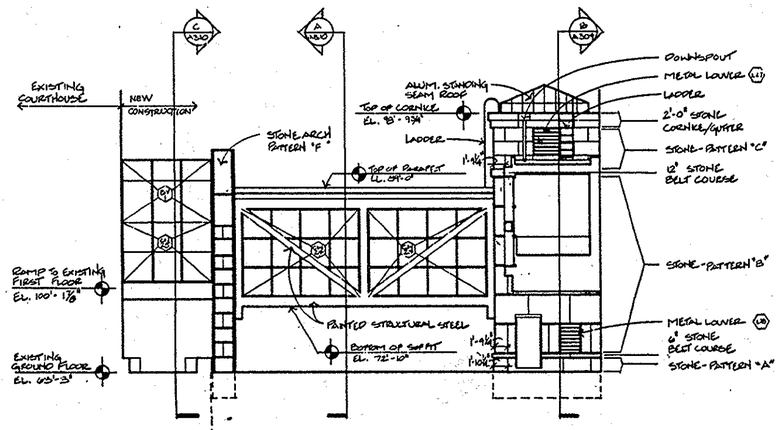

EAST SKYWALK ELEVATION – TO COURTHOUSE — 4 / A205

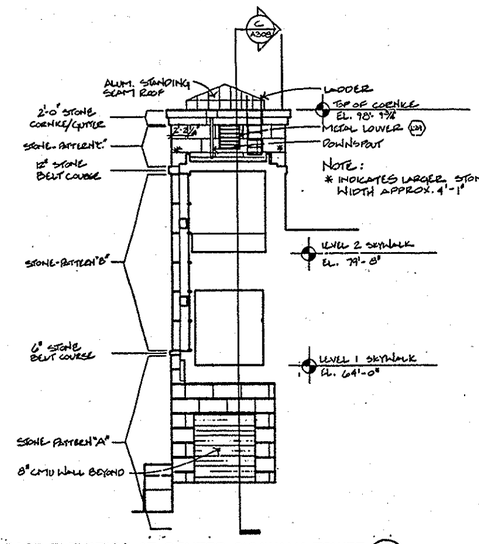

EAST ELEVATION AT CENTER SKYWALK TOWER — 5 / A205

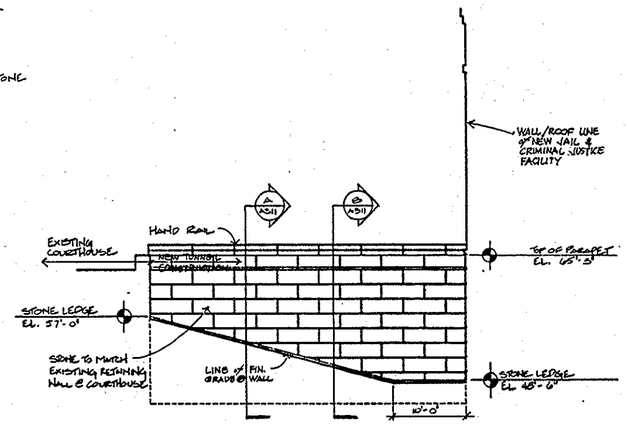

SOUTH EAST ELEVATION AT TUNNEL WALL — 6 / A205

NOTE:
TYPICAL BELT COURSE STONES ARE 7'-7" LOCATED AT ¢ OF JOINTS OF STONE PATTERN A&C

SHEET A-205	
15	

Joint Venture of:
the Zimmerman Design Group
Kahler Slater Torphy Architects
Architect Number 98003

Venture Architects

MILWAUKEE COUNTY DEPARTMENT OF PUBLIC WORKS
PROFESSIONAL SERVICES DIVISION
COURTHOUSE ANNEX 907 NORTH 10TH STREET MILWAUKEE, WISCONSIN 53233

REVISIONS

AS-BUILDT

SCALE: 1/8" = 1'-0" — DRAWN BY:
DATE: AUGUST 6, 1990 — CORRECTED BY:

PROJECT TITLE: MILWAUKEE COUNTY JAIL & CRIMINAL JUSTICE FACILITY Wisconsin
SHEET DESCRIPTION: EXTERIOR BUILDING ELEVATIONS

PROJECT NO. 01-4436
SHEET NO. A-205
FILE NO.

E-7-6

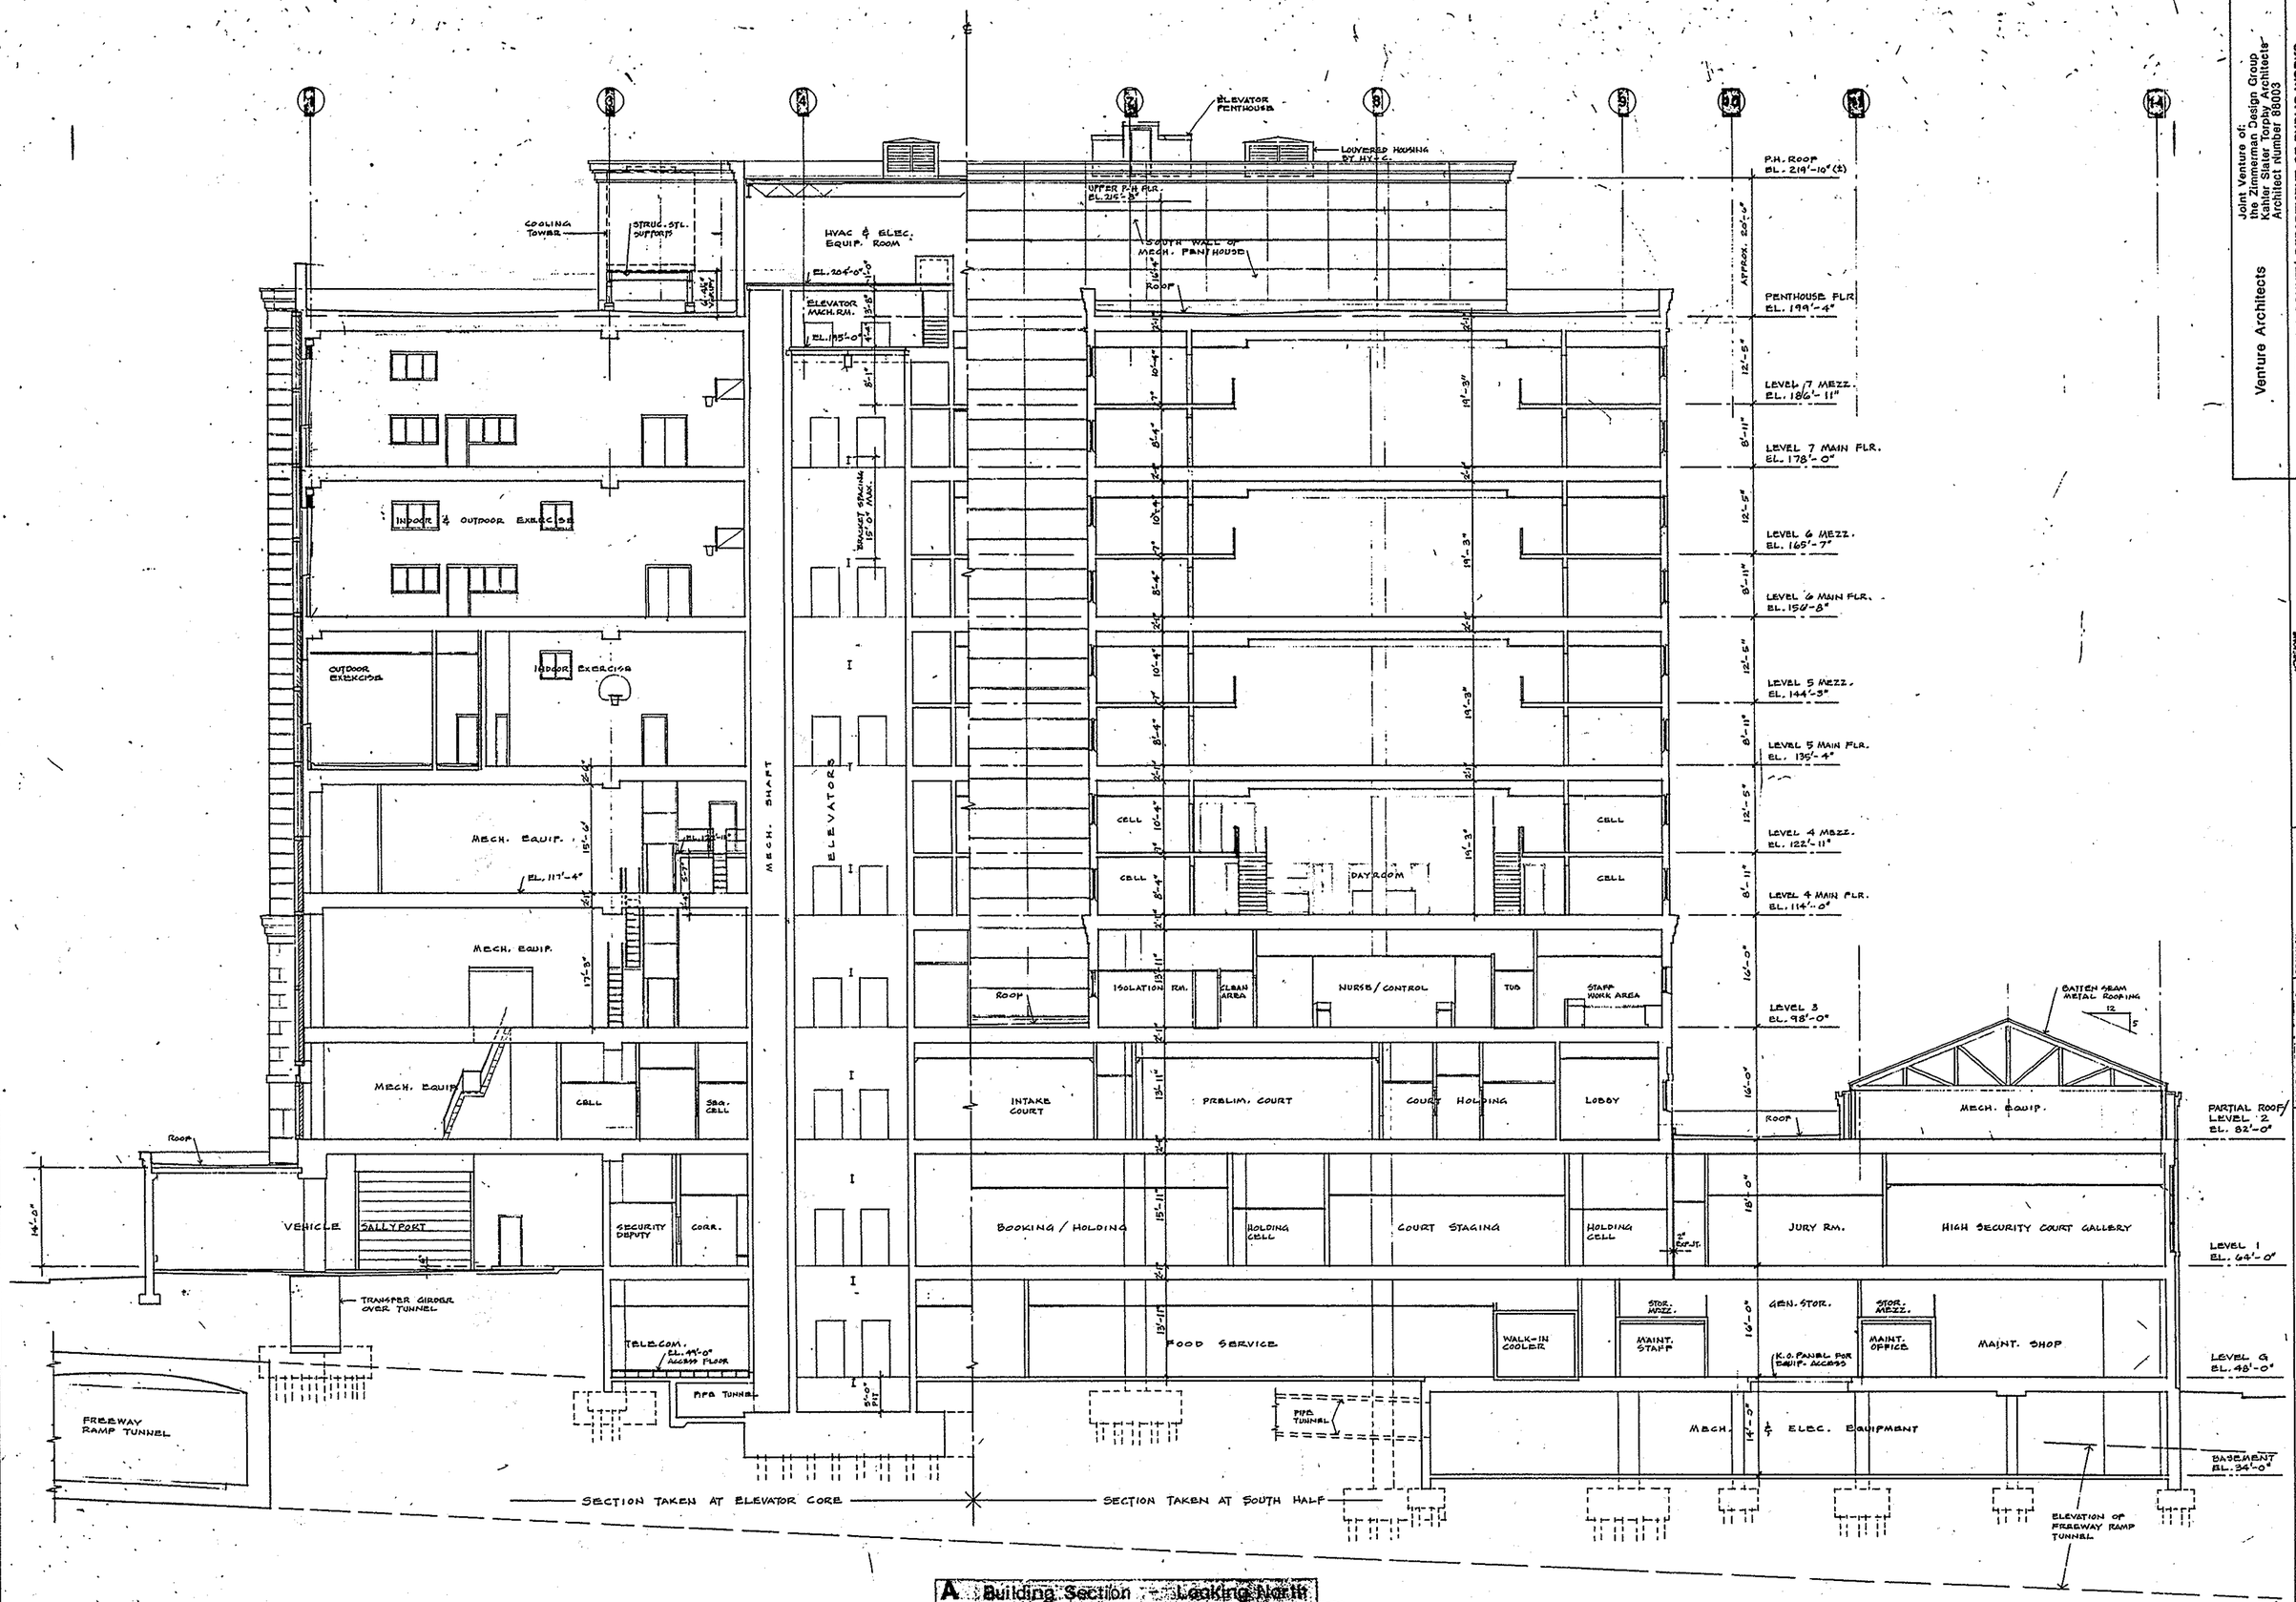

A Building Section - Looking North

Joint Venture of:
the Zimmerman Design Group
Kahler Slater Torphy Architects
Architect Number 88003

Venture Architects

MILWAUKEE COUNTY DEPARTMENT OF PUBLIC WORKS
PROFESSIONAL SERVICES DIVISION
COURTHOUSE ANNEX 907 NORTH 10TH STREET MILWAUKEE, WISCONSIN 53233

REVISIONS

AS-BUILT

DRAWN BY:
CHECKED BY:

SCALE: AS NOTED
DATE: AUGUST 6, 1990

PROJECT TITLE: MILWAUKEE COUNTY JAIL & CRIMINAL JUSTICE FACILITY
Milwaukee Wisconsin
SHEET DESCRIPTION: BUILDING SECTION

PROJECT NO. 01-4436

SHEET NO.
FILE NO.

A-250

E-7-6

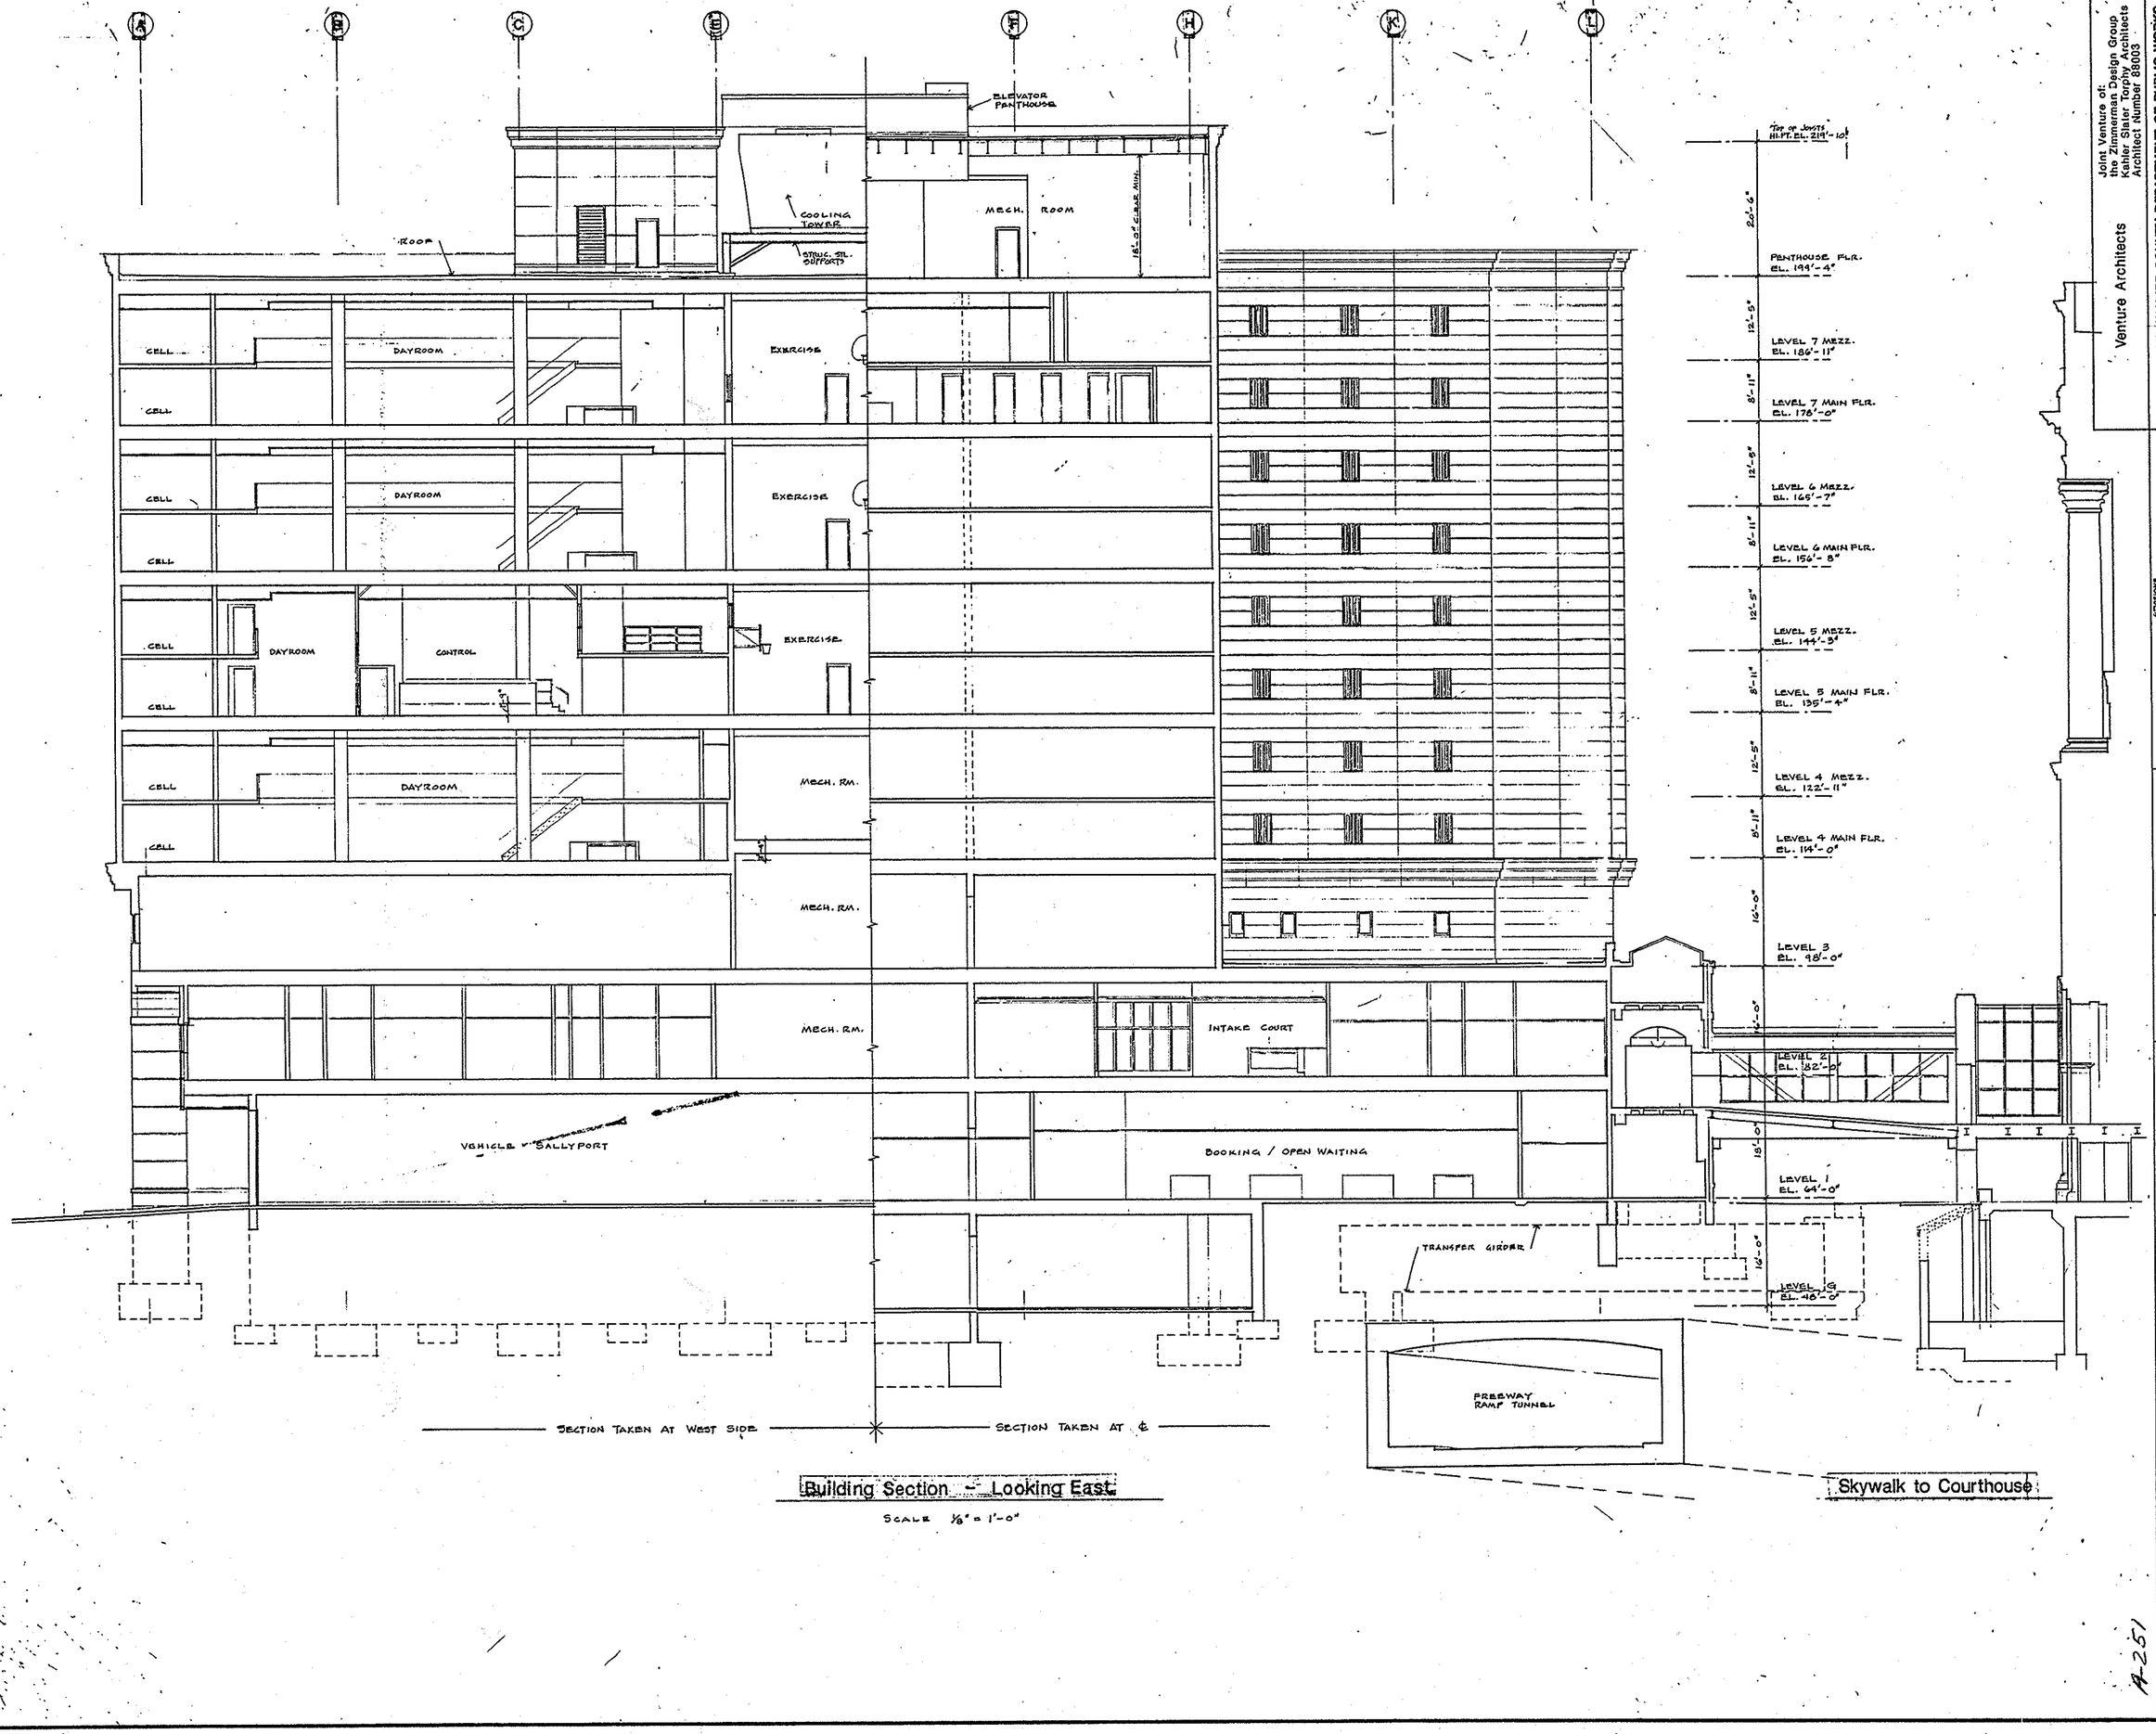

Building Section - Looking East

SCALE 1/8" = 1'-0"

Joint Venture of:
the Zimmerman Design Group
Kahler Slater Torphy Architects
Architect Number 88003

Venture Architects

MILWAUKEE COUNTY DEPARTMENT OF PUBLIC WORKS
PROFESSIONAL SERVICES DIVISION
COURTHOUSE ANNEX 907 NORTH 10TH STREET MILWAUKEE, WISCONSIN 53233

REVISIONS

AS-BUILT

PROJECT TITLE: MILWAUKEE COUNTY JAIL & CRIMINAL JUSTICE FACILITY
Milwaukee Wisconsin

SHEET DESCRIPTION: BUILDING SECTIONS

SCALE: AS NOTED
DATE: AUGUST 6, 1990

DRAWN BY:
CHECKED BY:

PROJECT NO. 01-4436

SHEET NO. A-251

FILE NO.

A-251

E-7

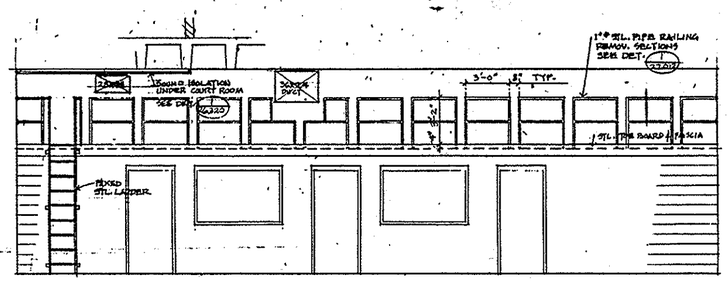

2 A252 Elevation - West Wall - Maint. Shop G0083
1/4" = 1'-0"

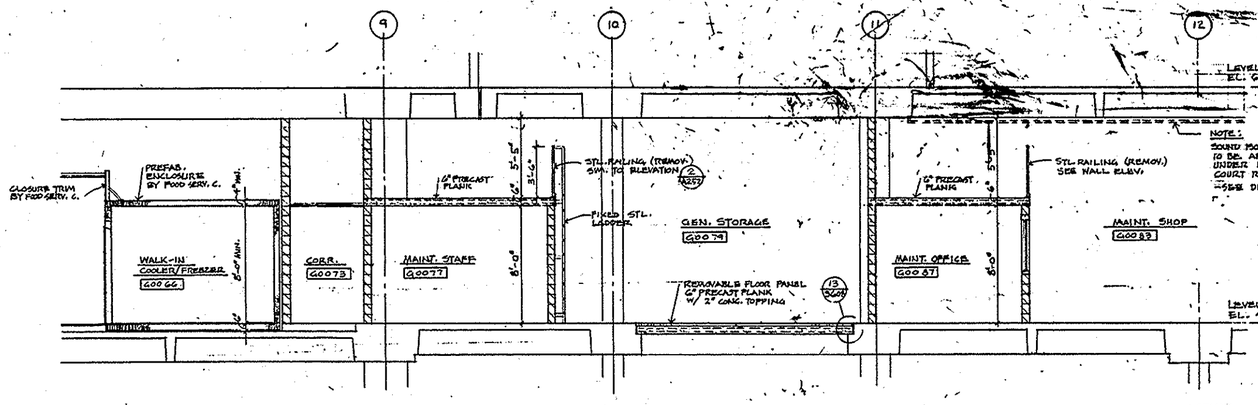

1 A252 Section - General Storage & Maintenance Shops
Section Looking North
1/4" = 1'-0"

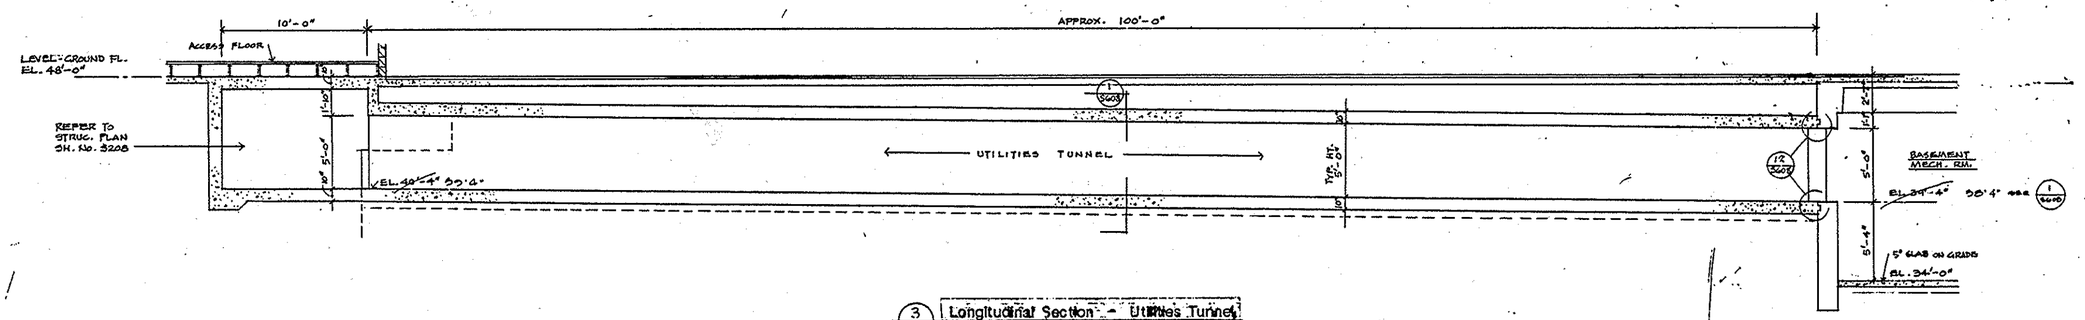

3 A252 Longitudinal Section - Utilities Tunnel
Section Looking North
1/4" = 1'-0"

Joint Venture of:
the Zimmerman Design Group
Kahler Slater Torphy Architects
Architect Number 82003

MILWAUKEE COUNTY DEPARTMENT OF PUBLIC WORKS
PROFESSIONAL SERVICES DIVISION
COURTHOUSE ANNEX / 307 NORTH 10TH STREET, MILWAUKEE, WISCONSIN 53233

AS-BUILT

SCALE: AS NOTED
DATE: AUGUST 6, 1990
DRAWN BY:
CHECKED BY:

PROJECT TITLE: MILWAUKEE COUNTY JAIL & CRIMINAL JUSTICE FACILITY
Milwaukee Wisconsin
SHEET DESCRIPTION: BUILDING SECTIONS

PROJECT NO. 01-4436
SHEET NO. A252
FILE NO.

A-252

E-7-6

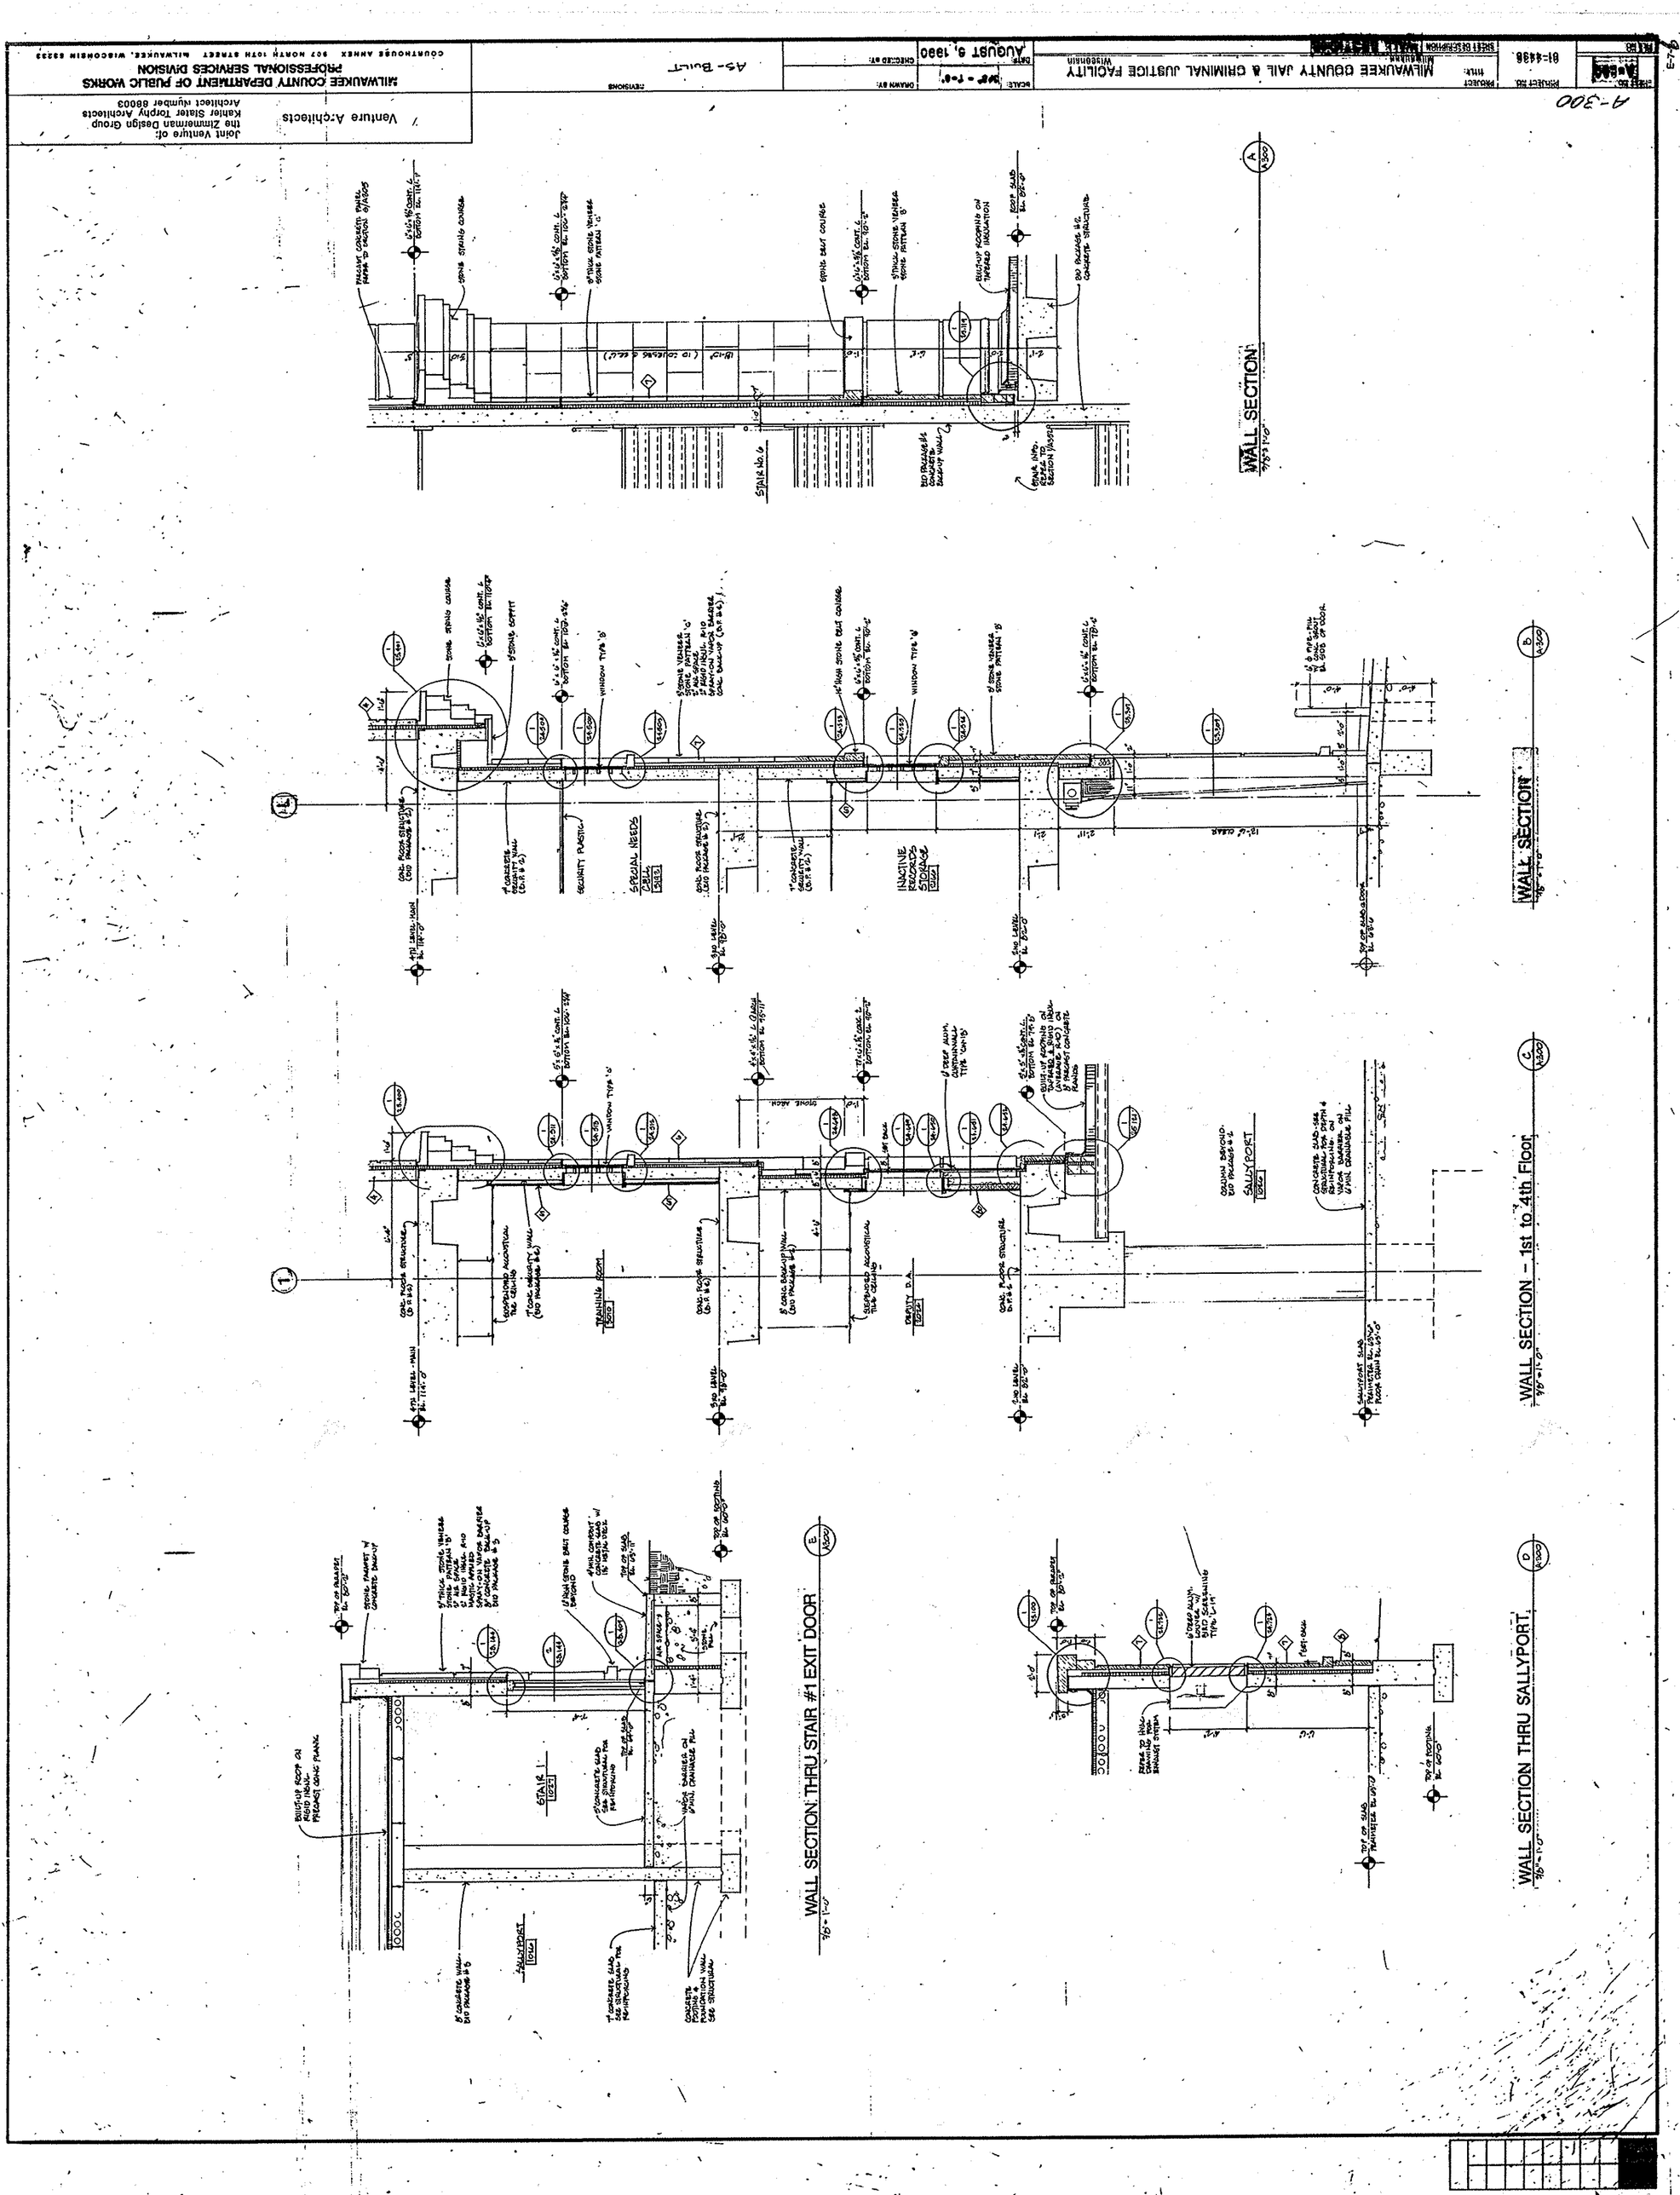

MILWAUKEE COUNTY DEPARTMENT OF PUBLIC WORKS
PROFESSIONAL SERVICES DIVISION
COURTHOUSE ANNEX 907 NORTH 10TH STREET MILWAUKEE, WISCONSIN 53233
Venture Architects
Joint Venture of:
the Zimmerman Design Group
Kahler Slater Torphy Architects
Architect Number 88003
AS-BUILT
AUGUST 9, 1990
MILWAUKEE COUNTY JAIL & CRIMINAL JUSTICE FACILITY
Wisconsin
81-4498
A-300
WALL SECTION
WALL SECTION - 1st to 4th Floor
WALL SECTION THRU STAIR #1 EXIT DOOR
WALL SECTION THRU SALLYPORT
SPECIAL NEEDS
INACTIVE RECORDS STORAGE
SALLYPORT
TRAINING ROOM
DEPUTY D.A.
STAIR 1

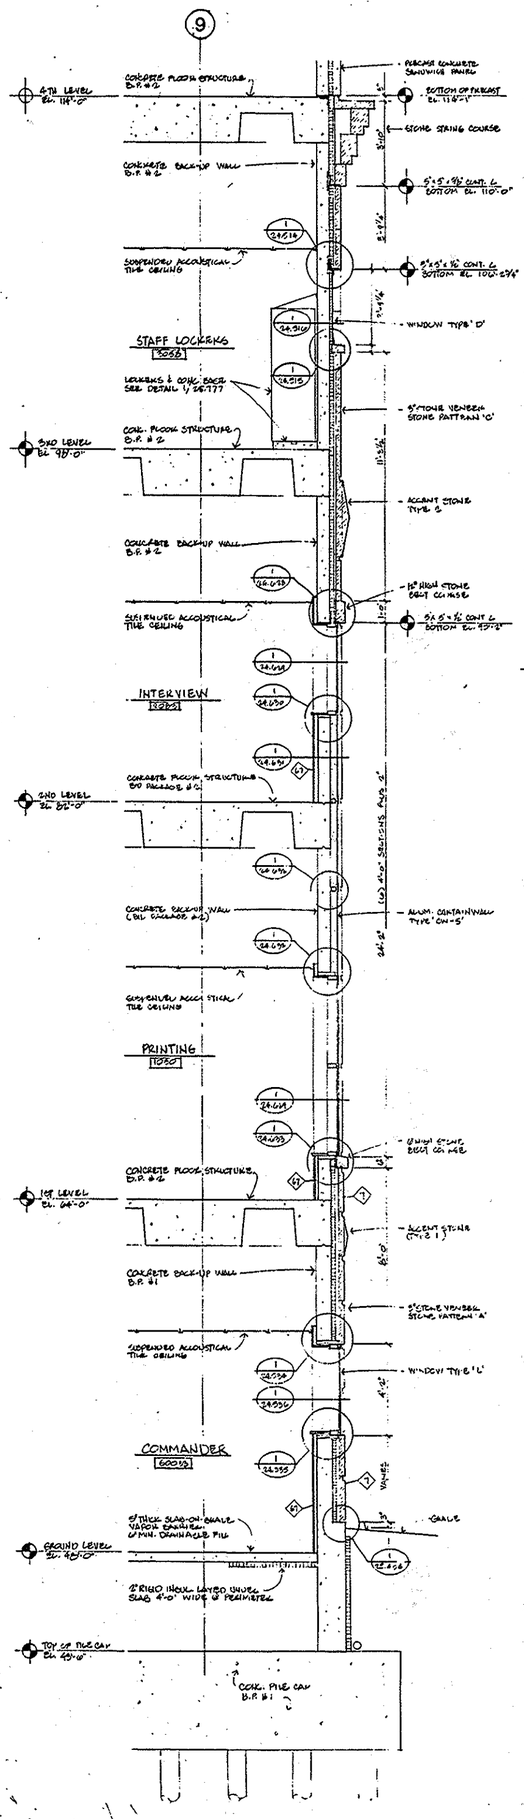

WALL SECTION – Ground to 4th Floor (E / A301)
3/8" = 1'-0"

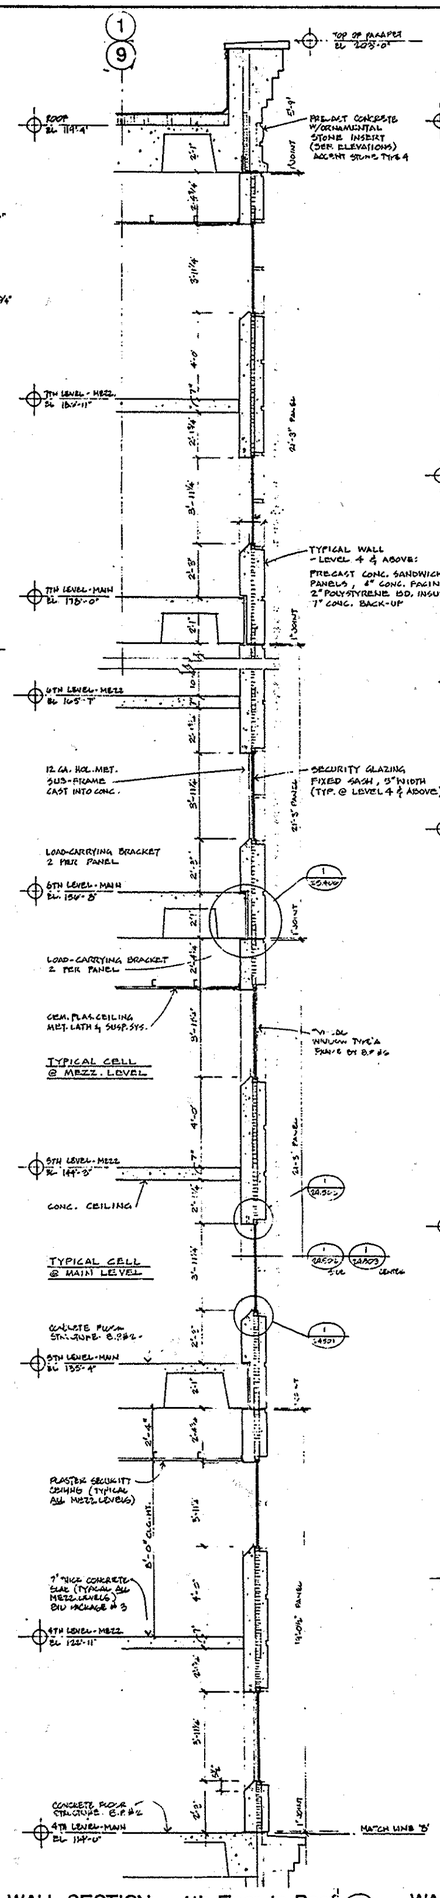

WALL SECTION – 4th Floor to Roof (D / A301)
3/8" = 1'-0"

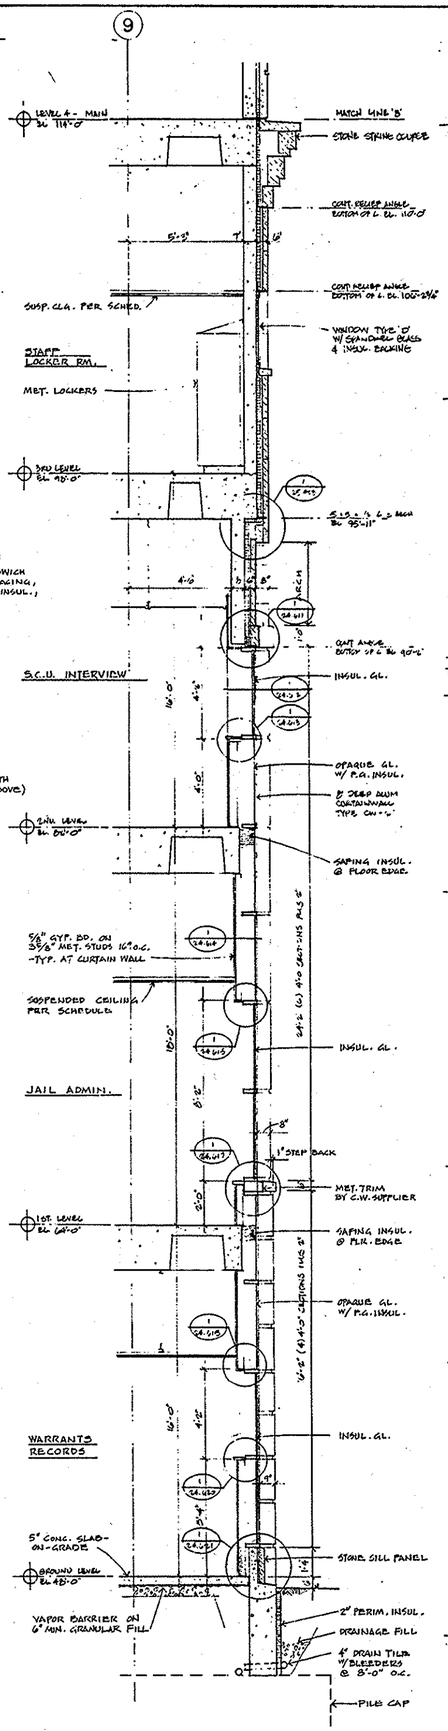

WALL SECTION – Ground to 4th Floor (C / A301)
3/8" = 1'-0"

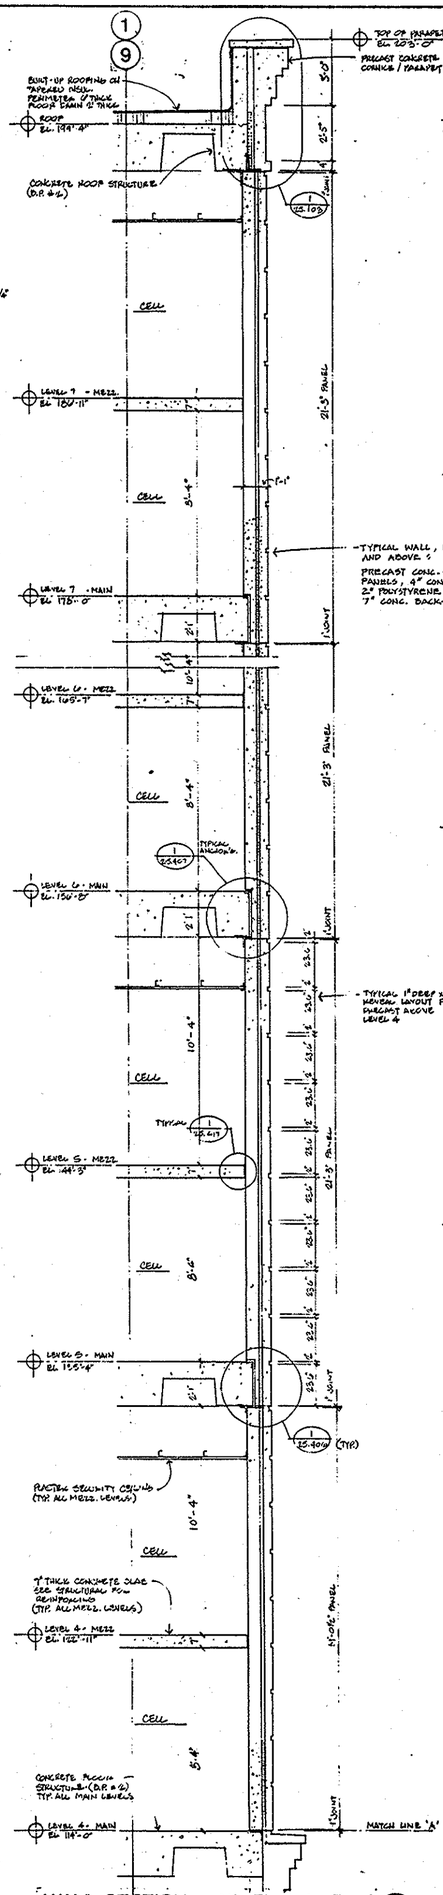

WALL SECTION – 4th Floor to Roof (B / A301)
3/8"-1'-0"

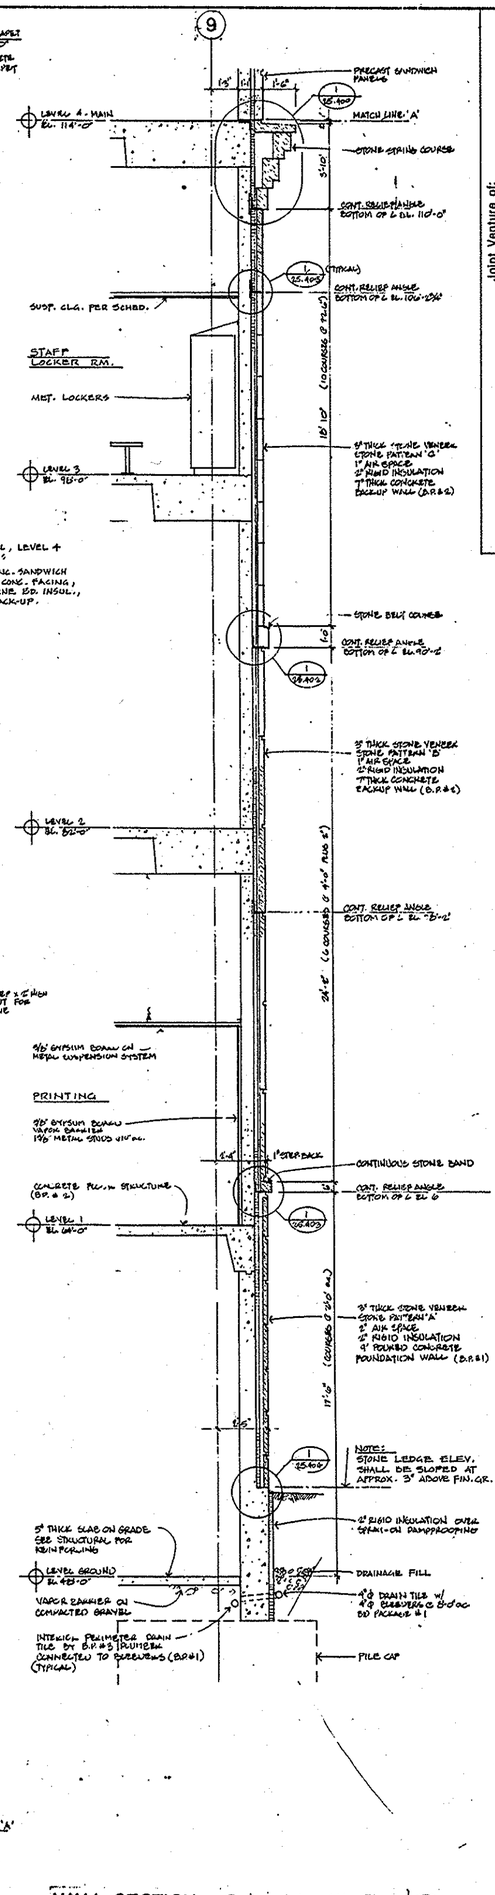

WALL SECTION – Ground to 4th Floor (A / A301)
3/8" = 1'-0"

Joint Venture of:
Ilse Zimmerman Design Group
Kahler Slater Torphy Architects
Architect Number 86003

Venture Architects

MILWAUKEE COUNTY DEPARTMENT OF PUBLIC WORKS
PROFESSIONAL SERVICES DIVISION
COURTHOUSE ANNEX 807 NORTH 16TH STREET MILWAUKEE, WISCONSIN 53233

REVISIONS

AS-BUILT

DRAWN BY:
CHECKED BY:

SCALE: 3/8" = 1'-0"
DATE: AUGUST 6, 1990

PROJECT TITLE: MILWAUKEE COUNTY JAIL & CRIMINAL JUSTICE FACILITY
WISCONSIN
SHEET DESCRIPTION: WALL SECTIONS

PROJECT NO. 01-4438

SHEET NO. A-301
P.B. NO.

E-7-6

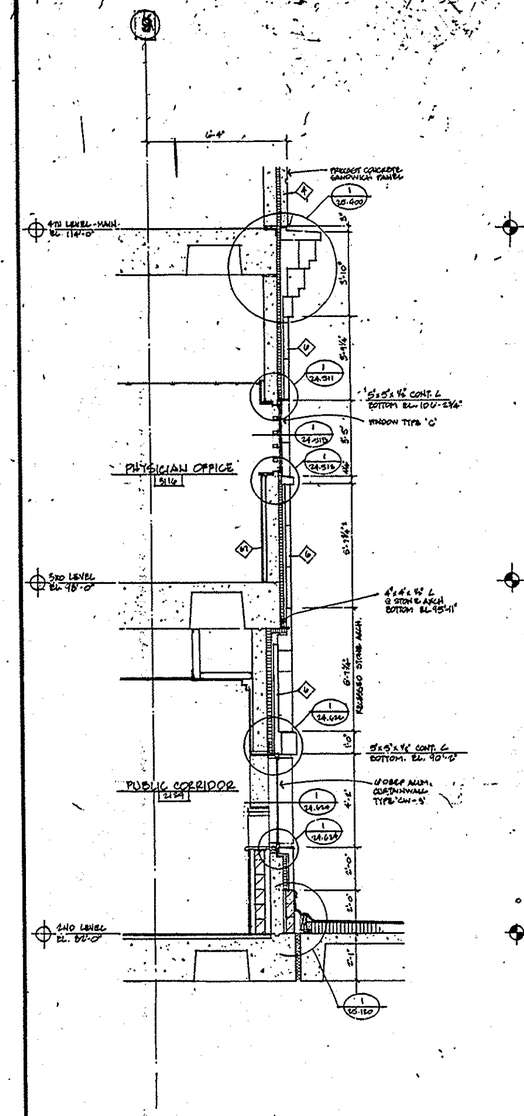

WALL SECTION @ EXPANSION JOINT E A302

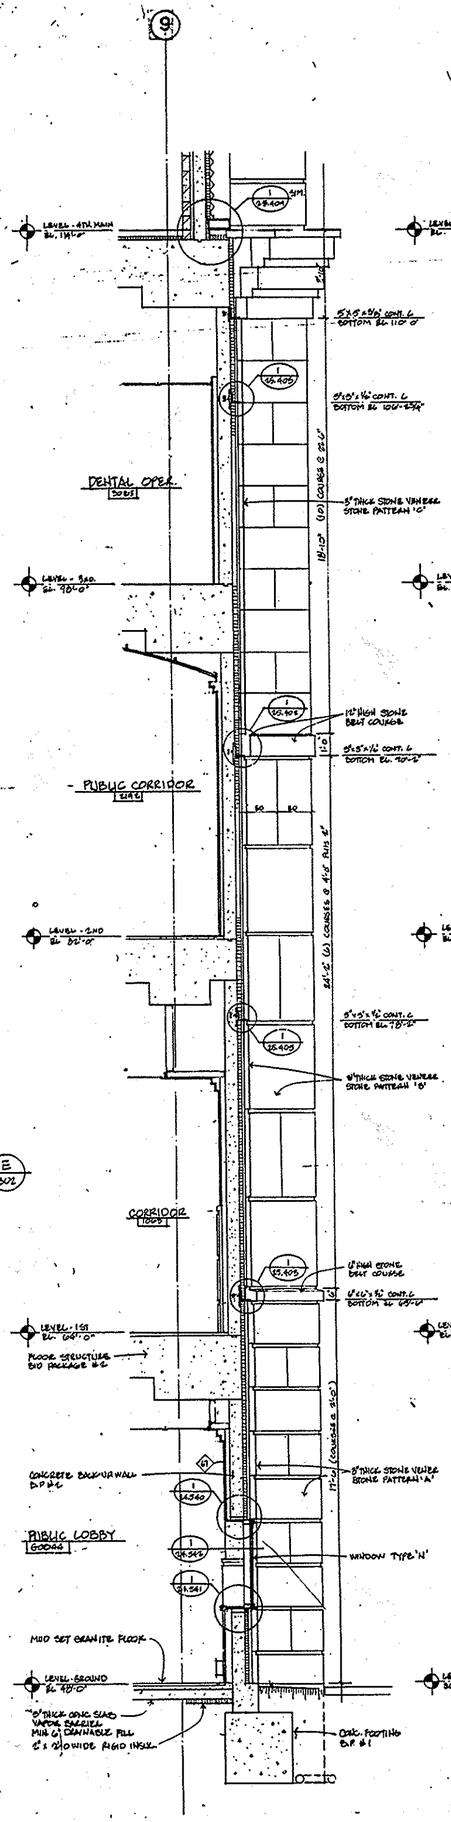

WALL SECTION - Ground to 4th Floor D A302

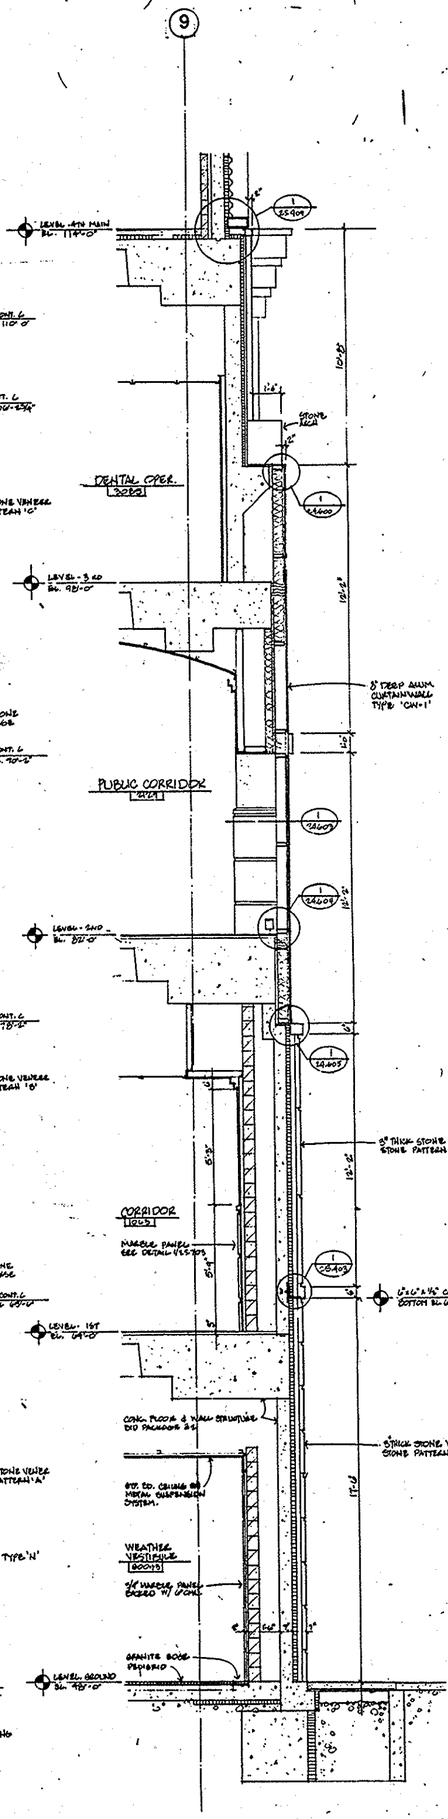

SECTION Thru ENTRY - Ground to 4th Floor C A302

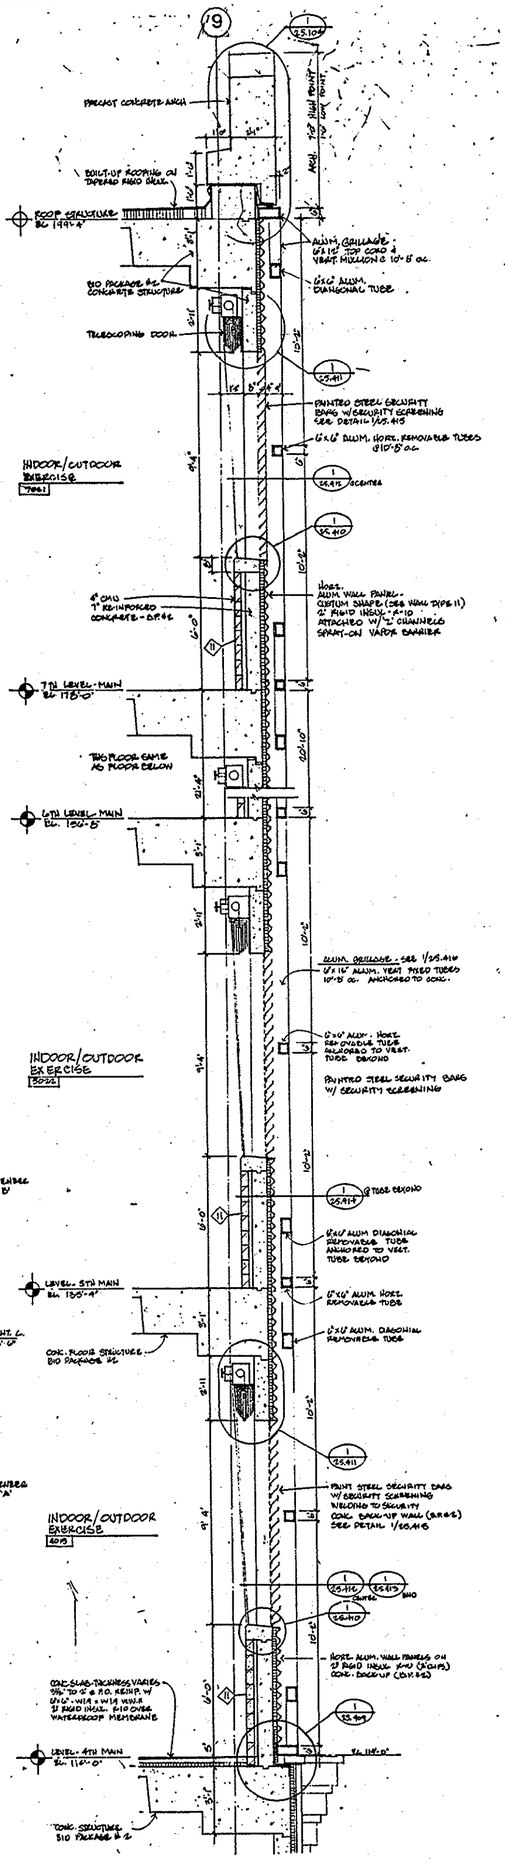

Section Thru Exercise - 4th to Roof B A302

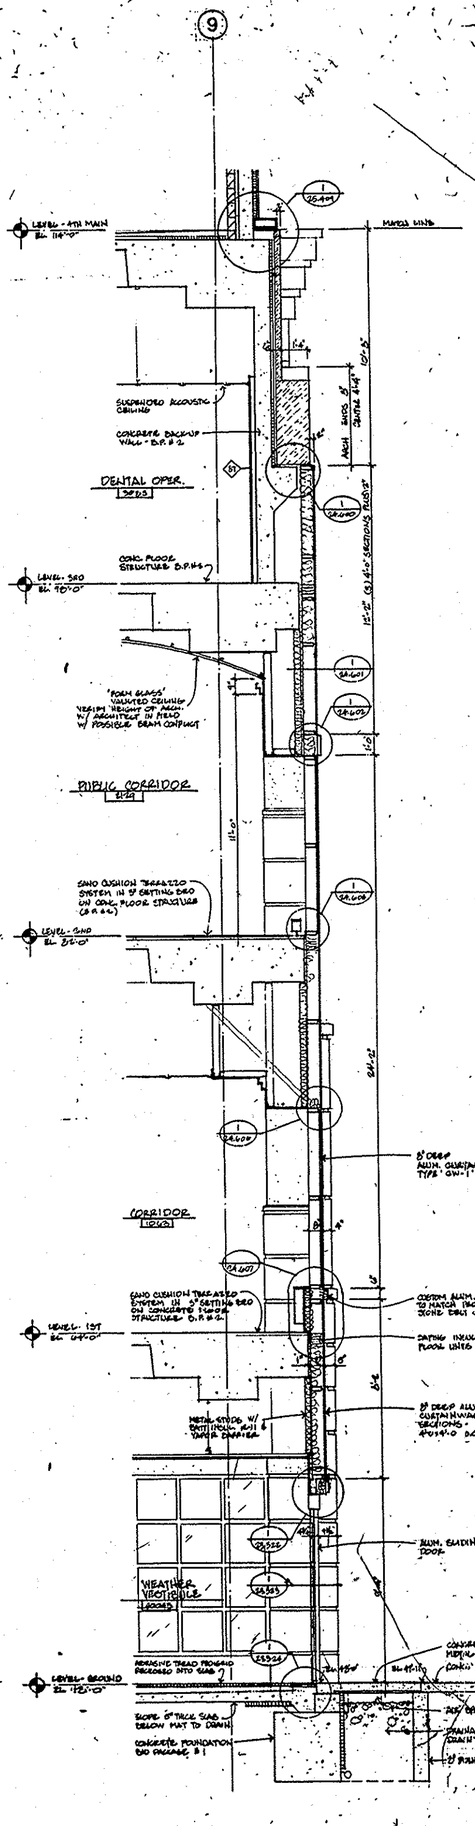

SECTION Thru ENTRY - Ground to 4th Floor A A302

Joint Venture of:
the Zimmerman Design Group
Kahler Slater Torphy Architects
Architect Number 88003

Venture Architects

MILWAUKEE COUNTY DEPARTMENT OF PUBLIC WORKS
PROFESSIONAL SERVICES DIVISION
COURTHOUSE ANNEX 907 NORTH 10TH STREET MILWAUKEE, WISCONSIN 53233

REVISIONS

AS-BUILT

DRAWN BY:
CHECKED BY:
SCALE: 3/8" = 1'-0"
DATE: AUGUST 6, 1993

PROJECT TITLE: MILWAUKEE COUNTY JAIL & CRIMINAL JUSTICE FACILITY Milwaukee, Wisconsin
SHEET DESCRIPTION

PROJECT NO. 01-4436

SHEET NO. A-302

E-7-6

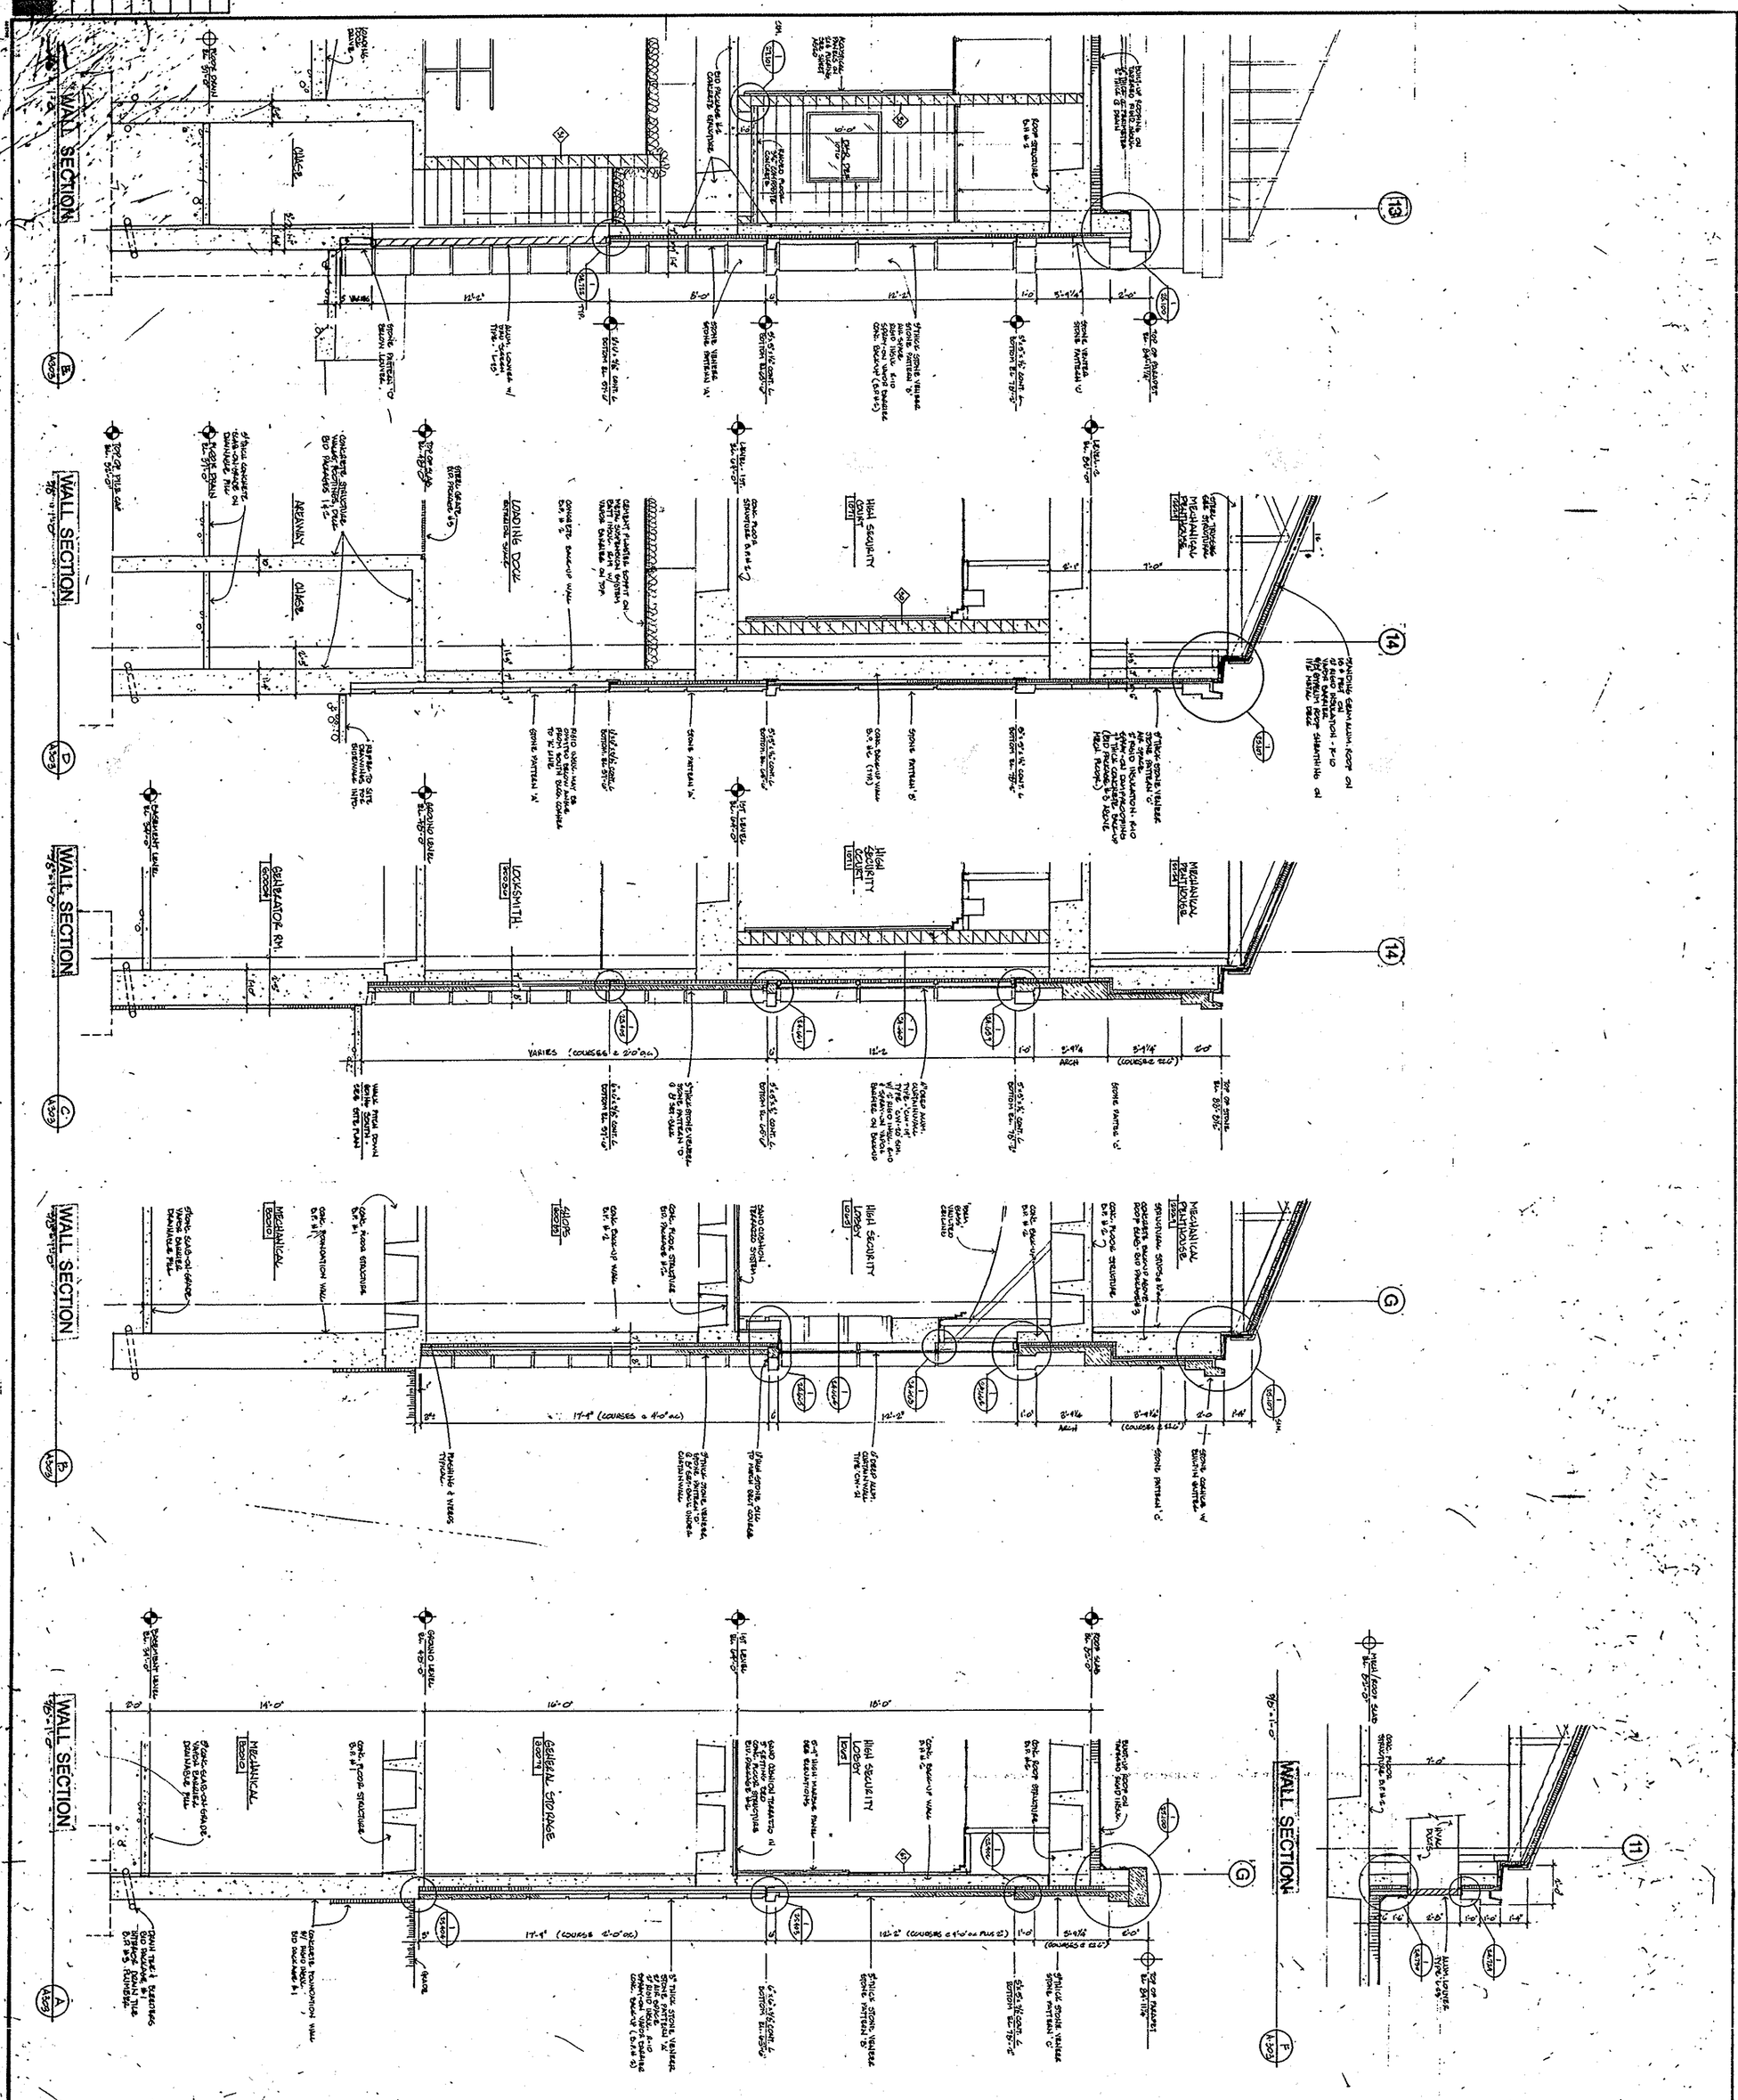

Venture Architects

Joint Venture of:
the Zimmerman Design Group
Kahler Slater Torphy Architects
Architect Number 88003

SHEET NO.	PROJECT NO.	PROJECT TITLE	SCALE	DRAWN BY	REVISIONS
A-303	01-4436	MILWAUKEE COUNTY JAIL & CRIMINAL JUSTICE FACILITY Milwaukee Wisconsin	3/8" = 1'-0"		AS-BUILT
FILE NO.		SHEET DESCRIPTION: [redacted]	DATE: AUGUST 6, 1990	CHECKED BY:	

MILWAUKEE COUNTY DEPARTMENT OF PUBLIC WORKS
PROFESSIONAL SERVICES DIVISION
COURTHOUSE ANNEX · 907 NORTH 10TH STREET MILWAUKEE, WISCONSIN 53233

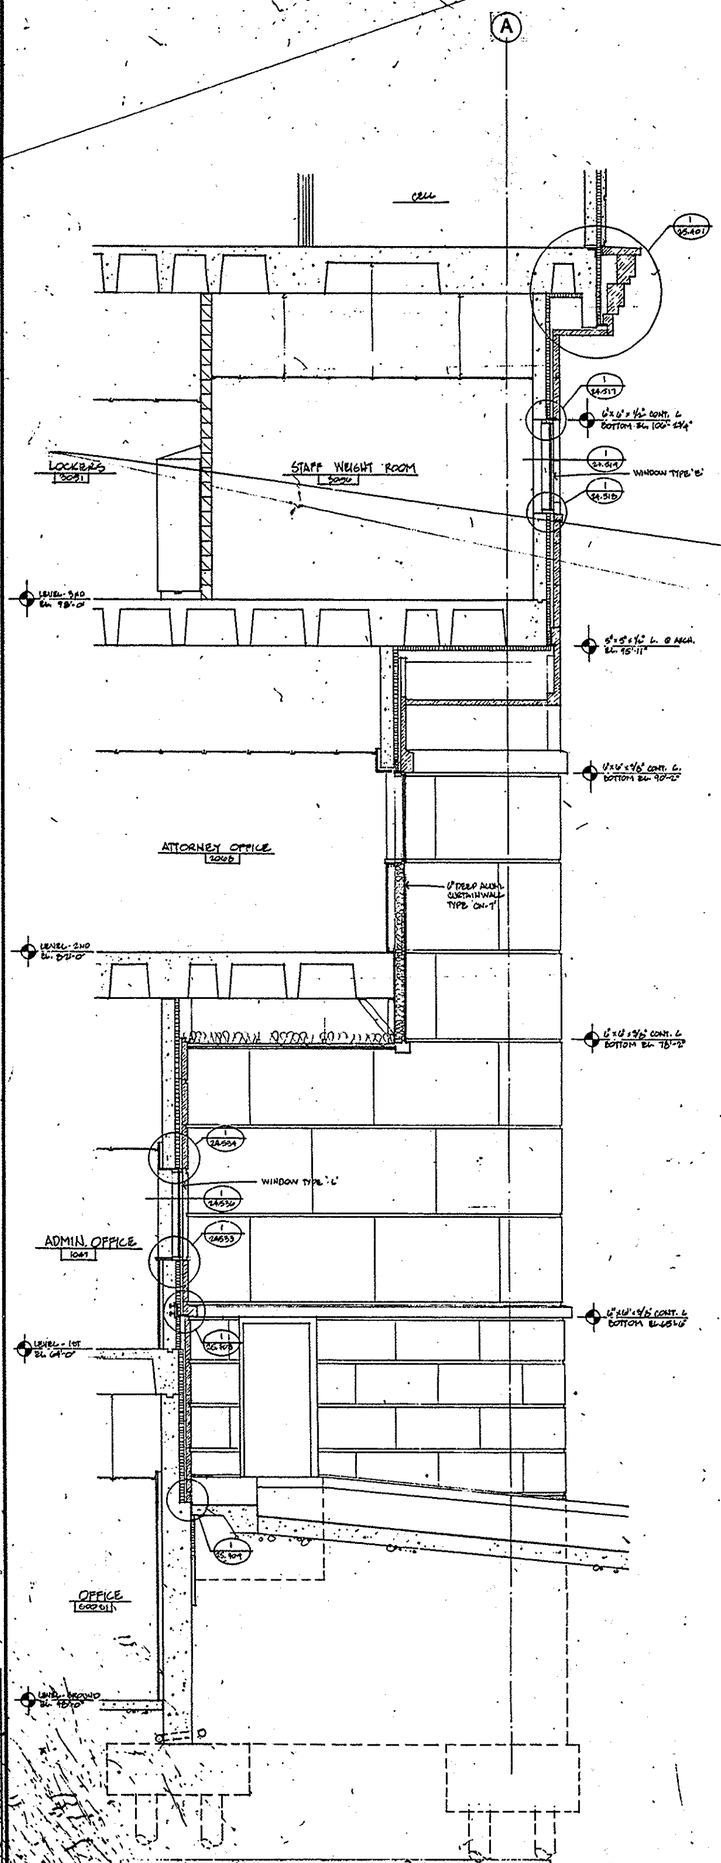

NORTH WALL SECTION - Ground to 4th Floor

C A304

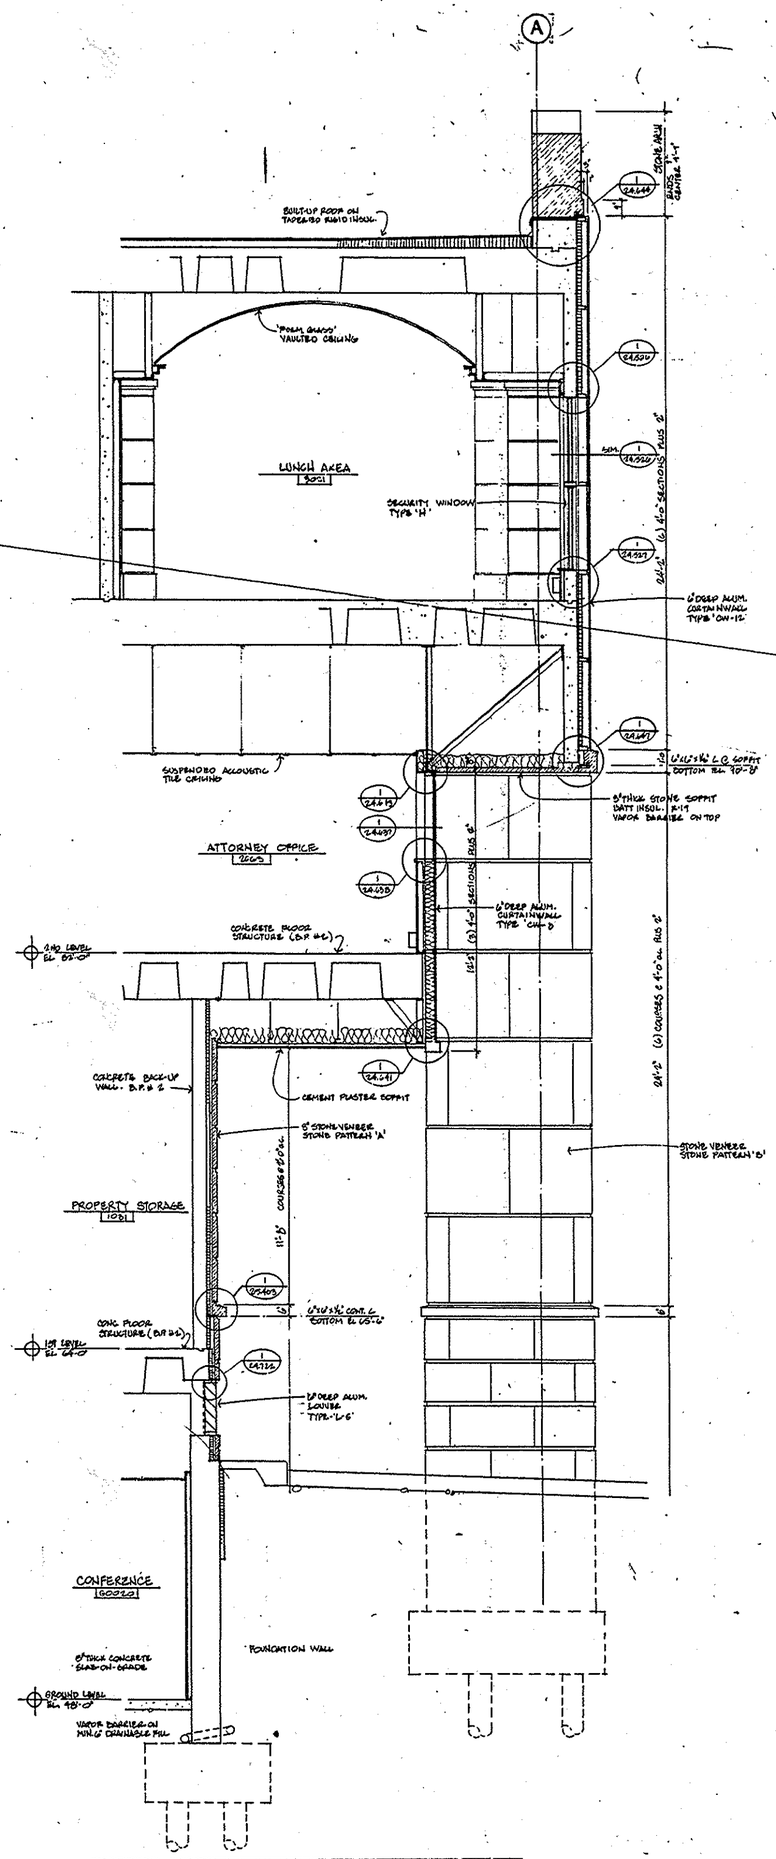

NORTH WALL SECTION - Ground to 4th Floor

B A304

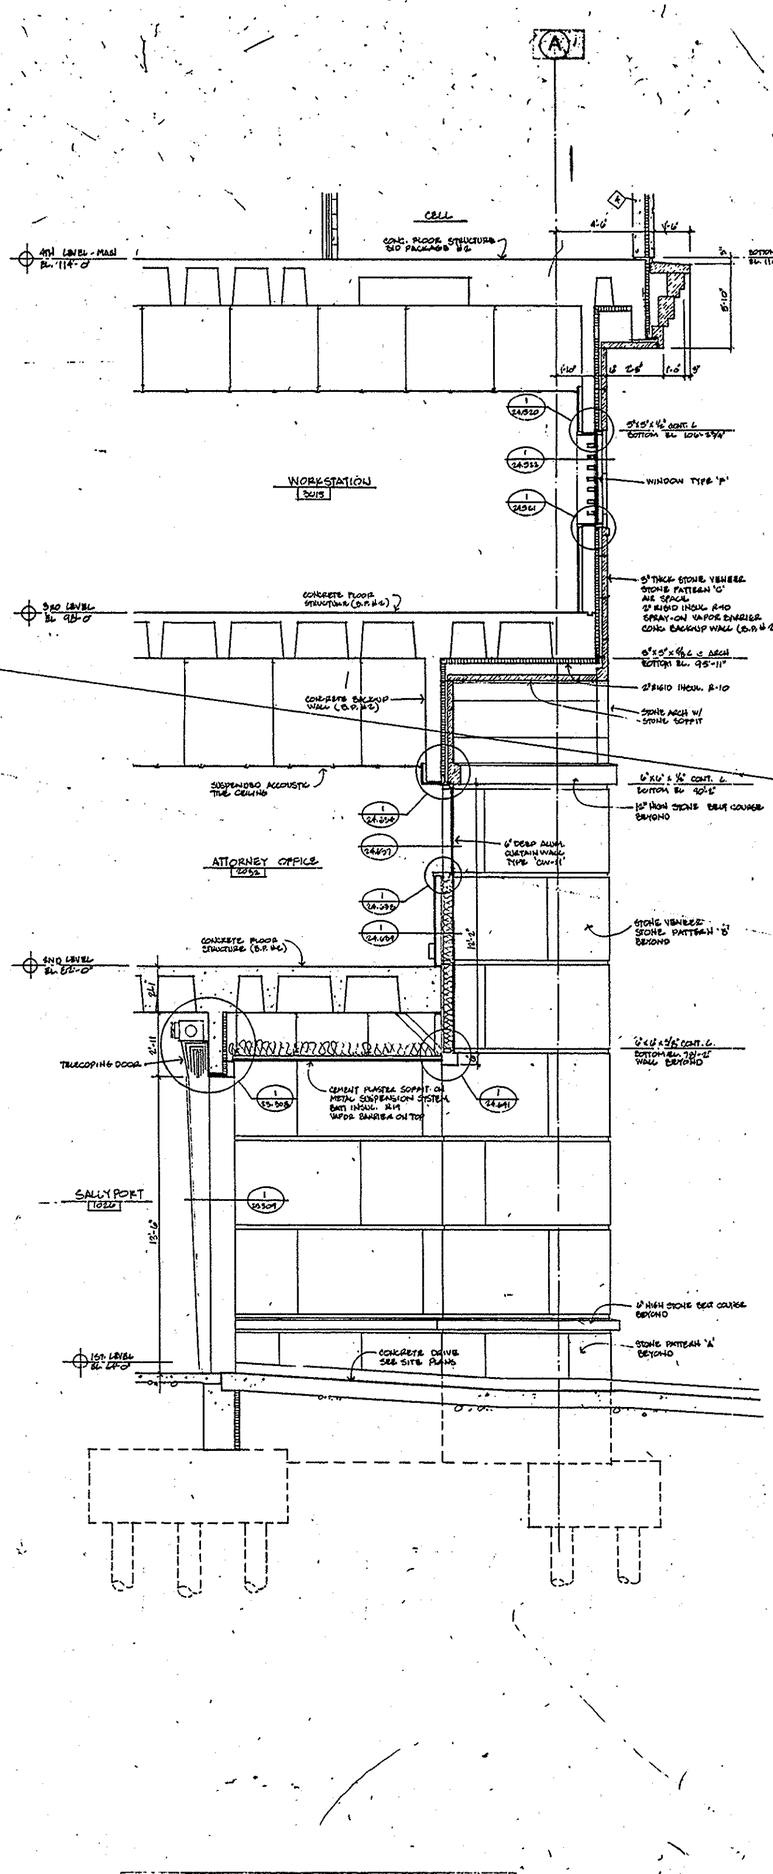

NORTH WALL SECTION - 1st to 4th Floor

A A304

Venture Architects

Joint Venture of:
the Zimmerman Design Group
Kahler Slater Torphy Architects
Architect number 98003

MILWAUKEE COUNTY DEPARTMENT OF PUBLIC WORKS
PROFESSIONAL SERVICES DIVISION
COURTHOUSE ANNEX 907 NORTH 10TH STREET MILWAUKEE, WISCONSIN 53233

REVISIONS
AS-BUILT

SCALE: 3/8" = 1'-0"
DRAWN BY:
CHECKED BY:
DATE: AUGUST 6, 1990

PROJECT TITLE: MILWAUKEE COUNTY JAIL & CRIMINAL JUSTICE FACILITY
Milwaukee, Wisconsin
SHEET DESCRIPTION: BUILDING SECTIONS

PROJECT NO. 01-4436

SHEET NO. A-304

PLOT DATE: 8/6/90

AE-7-6

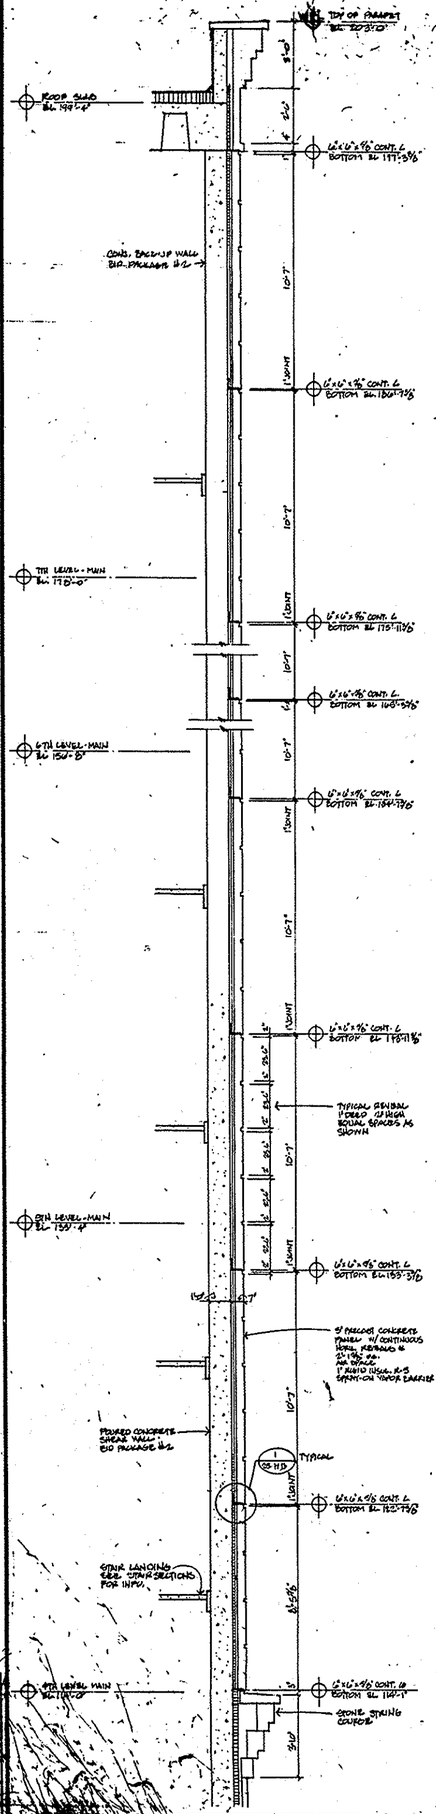

SECTION @ STAIR – 4th to Roof (G A305)

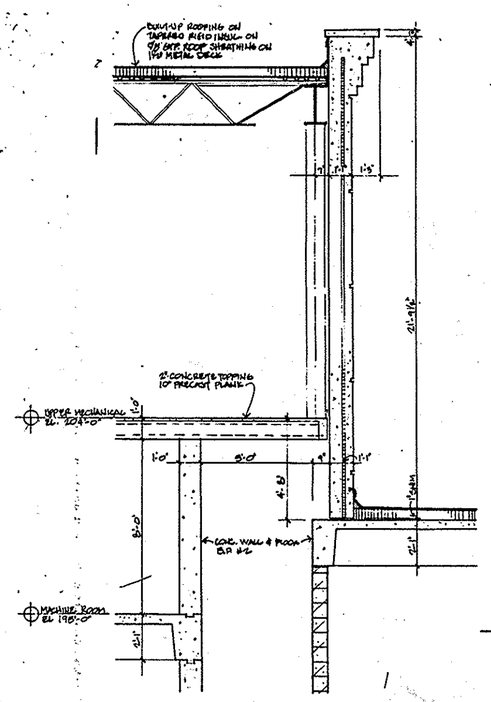

SECTION Thru Upper Mechanical (E A305)

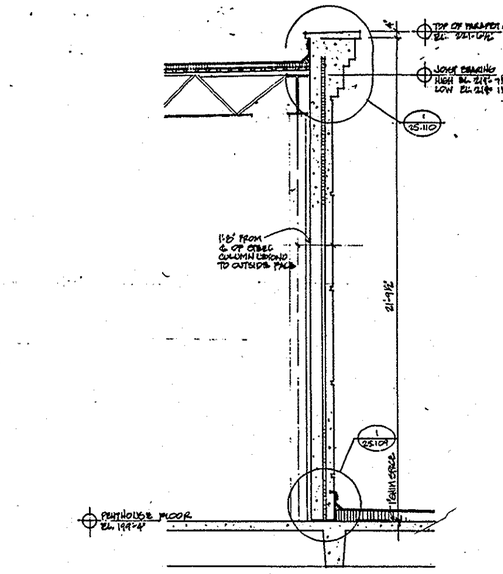

WALL SECTION – 4th Floor to Penthouse Roof (C A305)

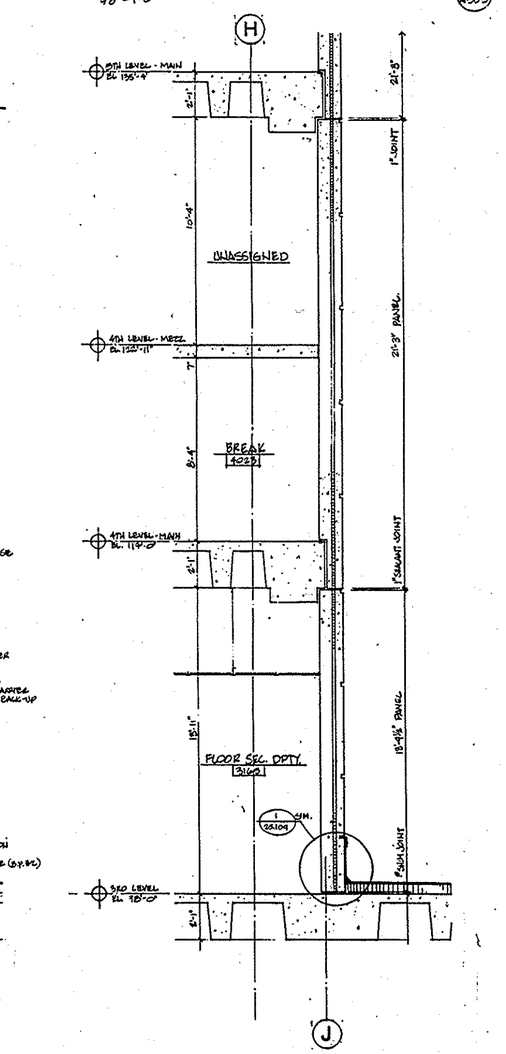

PARTIAL SECTION – 3rd to 4th Floor (F A305)

PARTIAL SECTION – 3rd Floor to 5th Floor (D A305)

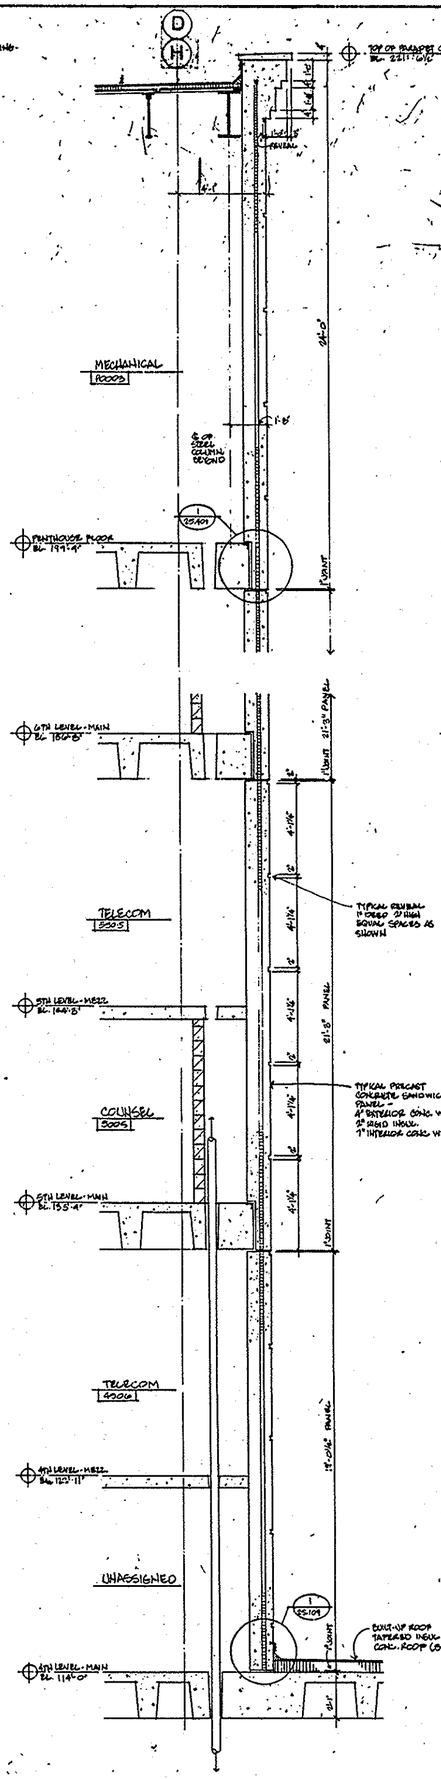

WALL SECTION – Roof to Penthouse Roof (B A305)

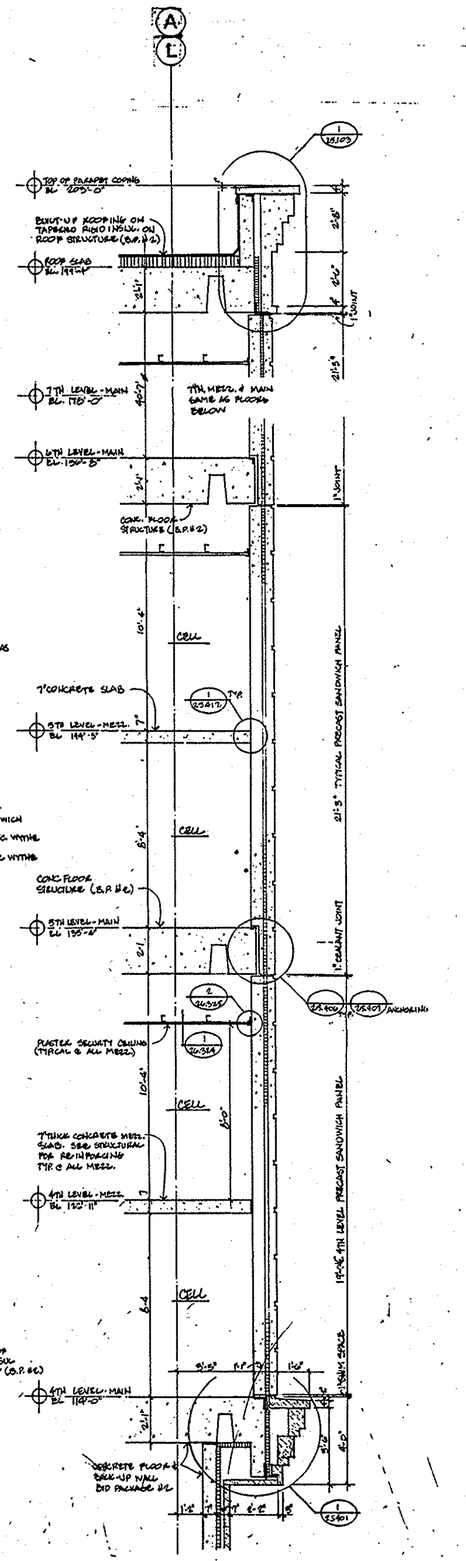

WALL SECTION – 4th Floor to Roof (A A305)

Joint Venture of:
the Zimmerman Design Group
Kahler Slater Torphy Architects
Architect number 88003

Venture Architects

MILWAUKEE COUNTY DEPARTMENT OF PUBLIC WORKS
PROFESSIONAL SERVICES DIVISION
COURTHOUSE ANNEX 927 NORTH 10TH STREET MILWAUKEE, WISCONSIN 53233

REVISIONS
AS-BUILDT

DRAWN BY:
CHECKED BY:
SCALE: 3/4" = 1'-0"
DATE: AUGUST 9, 1993

PROJECT TITLE: MILWAUKEE COUNTY JAIL & CRIMINAL JUSTICE FACILITY
Milwaukee Wisconsin
SHEET DESCRIPTION:

PROJECT NO. 01-4438

SHEET NO. A-305

A-305

E-7-6

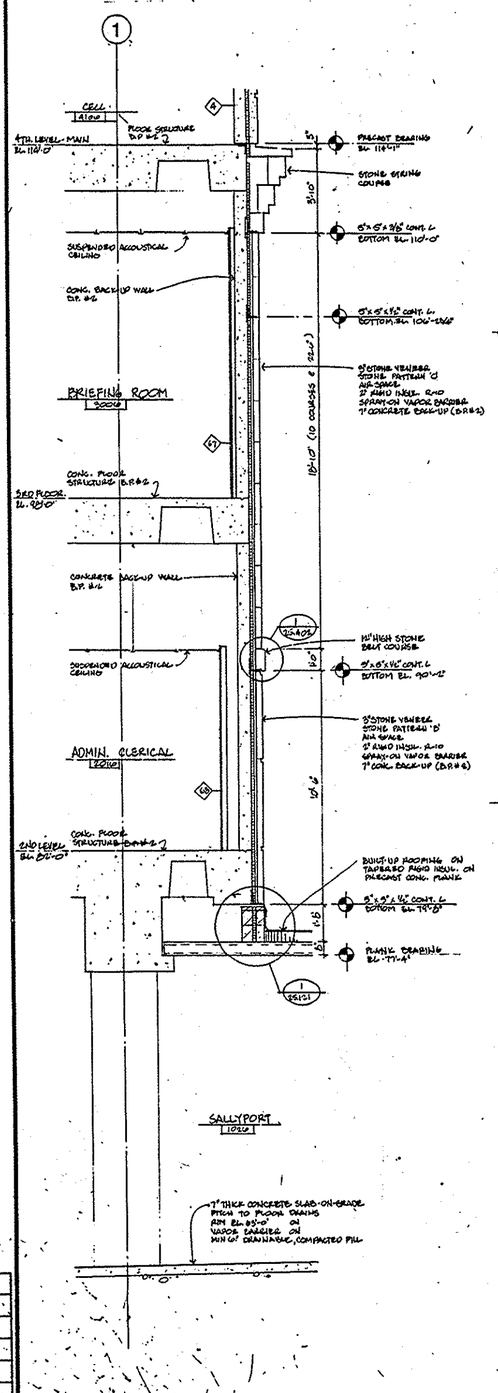

WEST WALL SECTION - 1st to 4th Floor — P — A-306
3/8" = 1'-0"

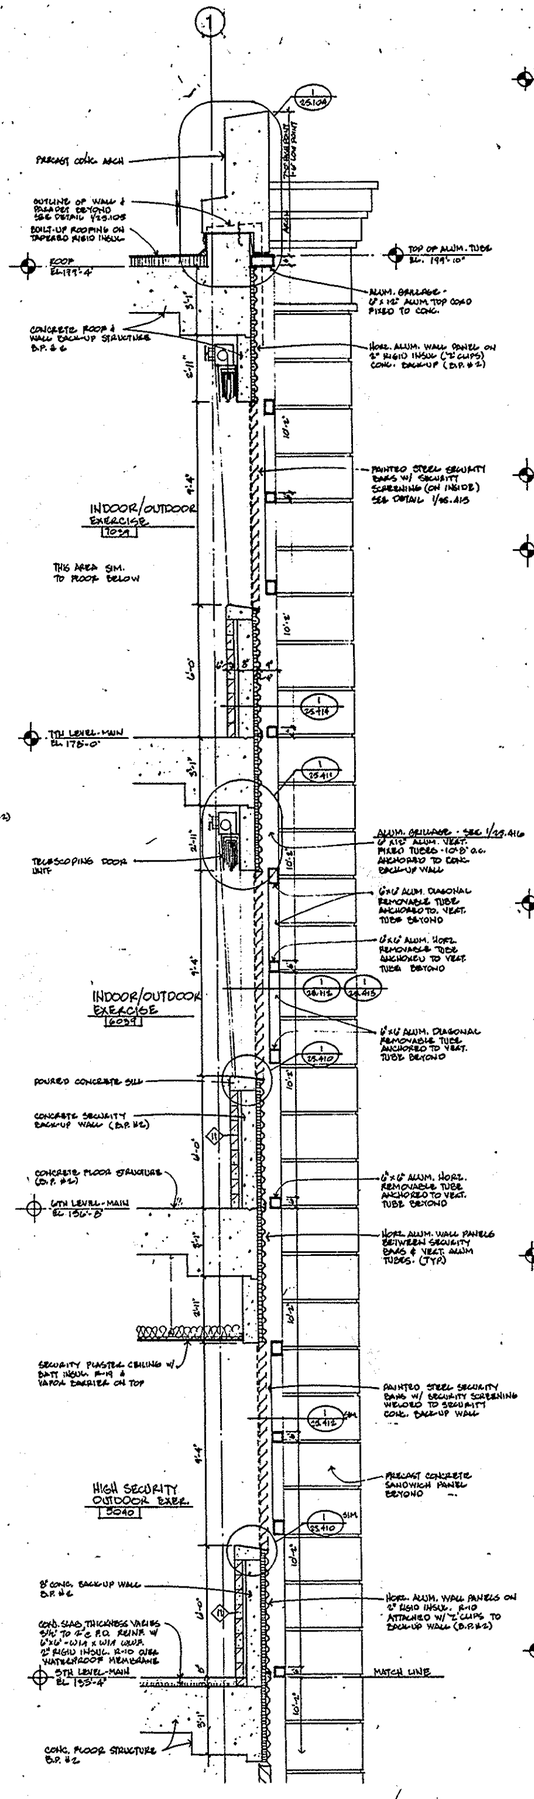

WEST WALL SECTION - 5th to Roof — E — A-306
3/8" = 1'-0"

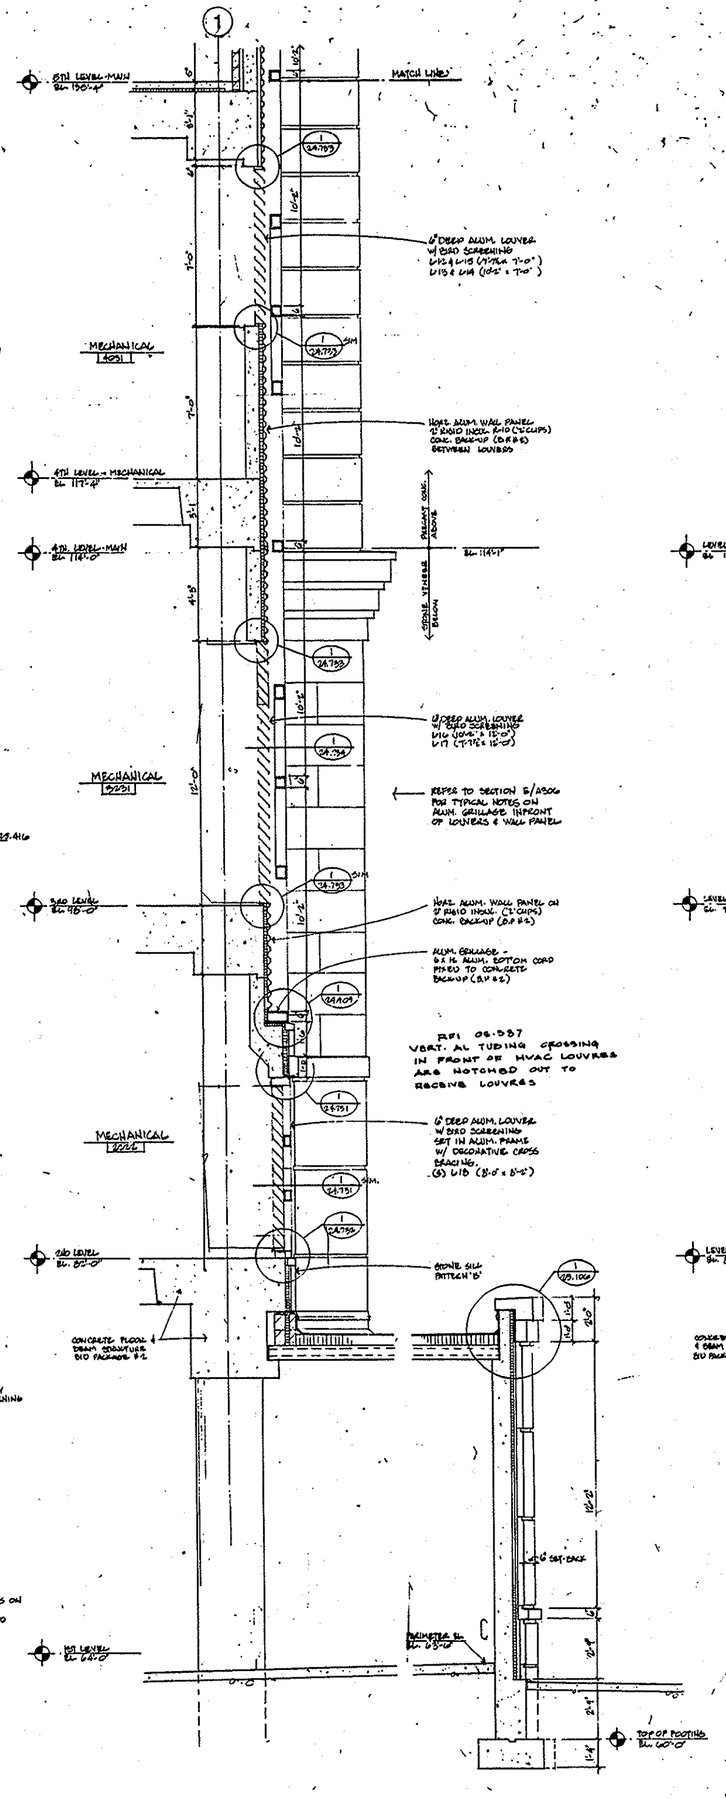

WEST WALL SECTION - 1st to 5th Floor — D — A-306
3/8" = 1'-0"

WEST WALL @ SALLYPORT — C — A-306
3/8" = 1'-0"

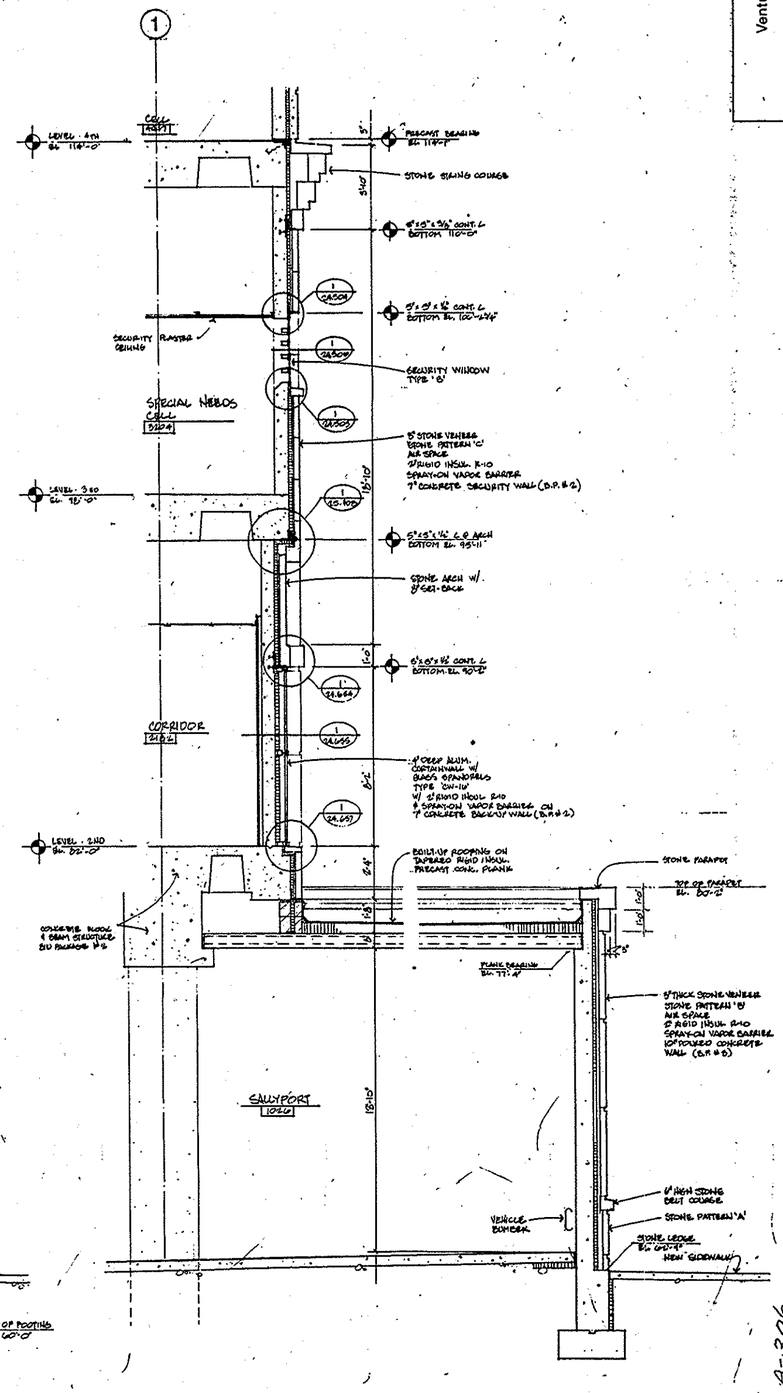

WEST WALL @ SALLYPORT — A — A-306
3/8" = 1'-0"

Joint Venture of:
the Zimmerman Design Group
Kahler Slater Torphy Architects
Architect Number 88003

Venture Architects

CHANGE DOCUMENTS:
RFI 05-337

MILWAUKEE COUNTY DEPARTMENT OF PUBLIC WORKS
PROFESSIONAL SERVICES DIVISION
COURTHOUSE ANNEX 907 NORTH 10TH STREET MILWAUKEE, WISCONSIN 53233

REVISIONS
AS-BUILT

SCALE: 3/8" = 1'-0"
DRAWN BY:
CHECKED BY:
DATE: AUGUST 5, 1990

PROJECT TITLE: MILWAUKEE COUNTY JAIL & CRIMINAL JUSTICE FACILITY Milwaukee, Wisconsin
SHEET DESCRIPTION:
PROJECT NO. 01-9436
SHEET NO. A-306

E-7-6

CHANGE DOCUMENT: RFI. 20 \ 102

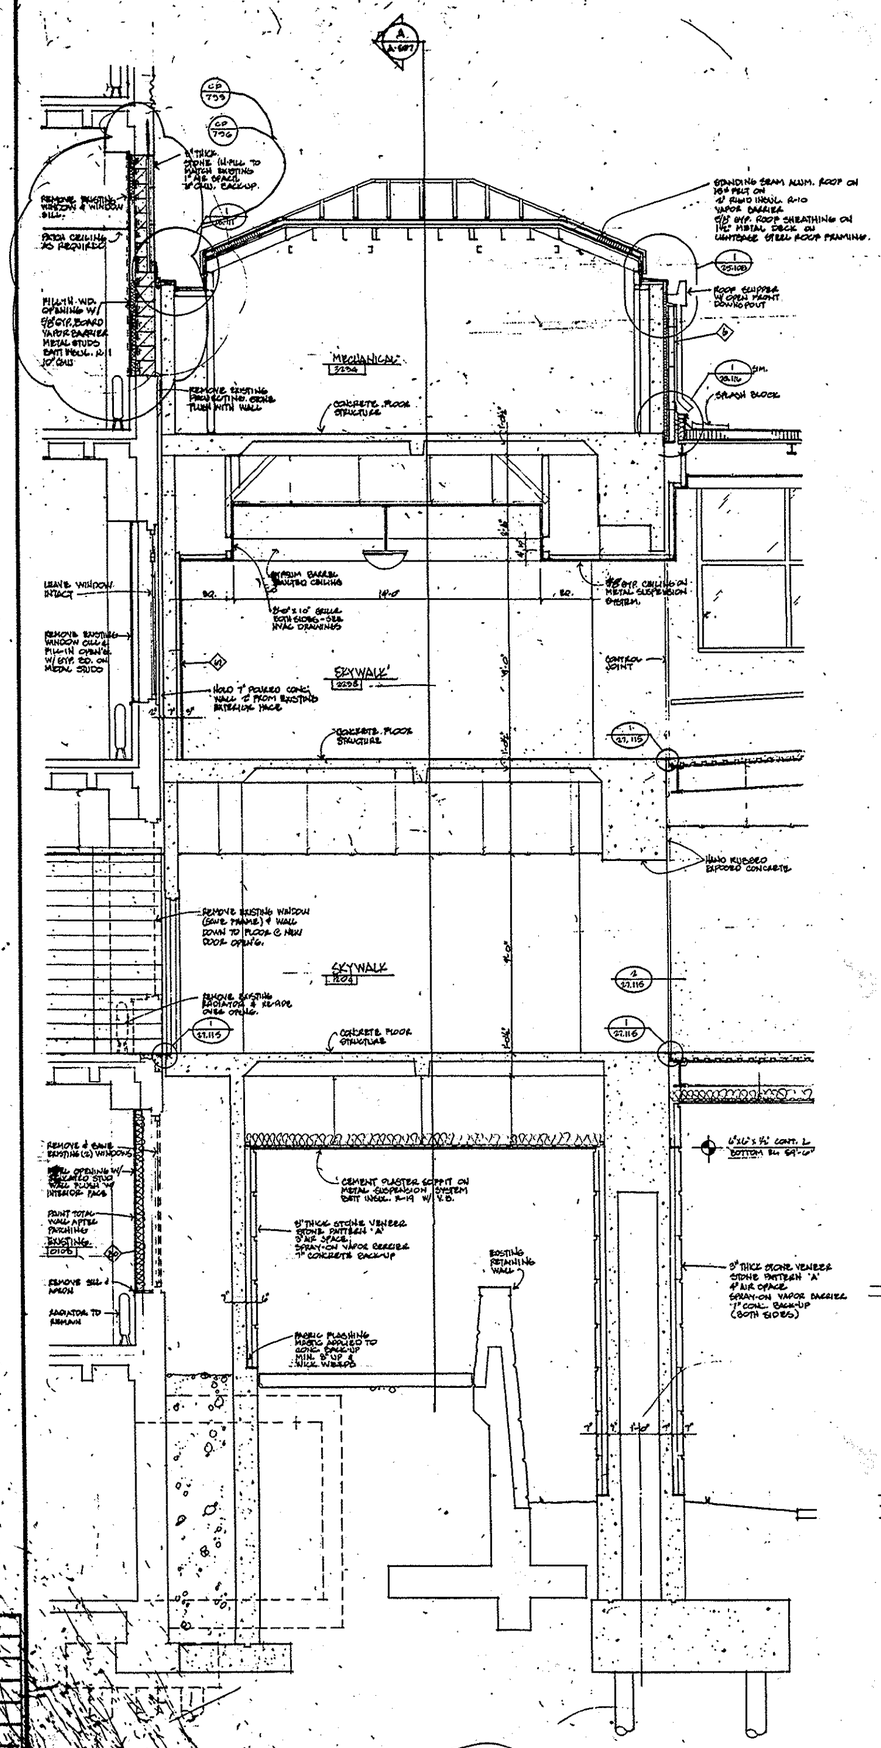

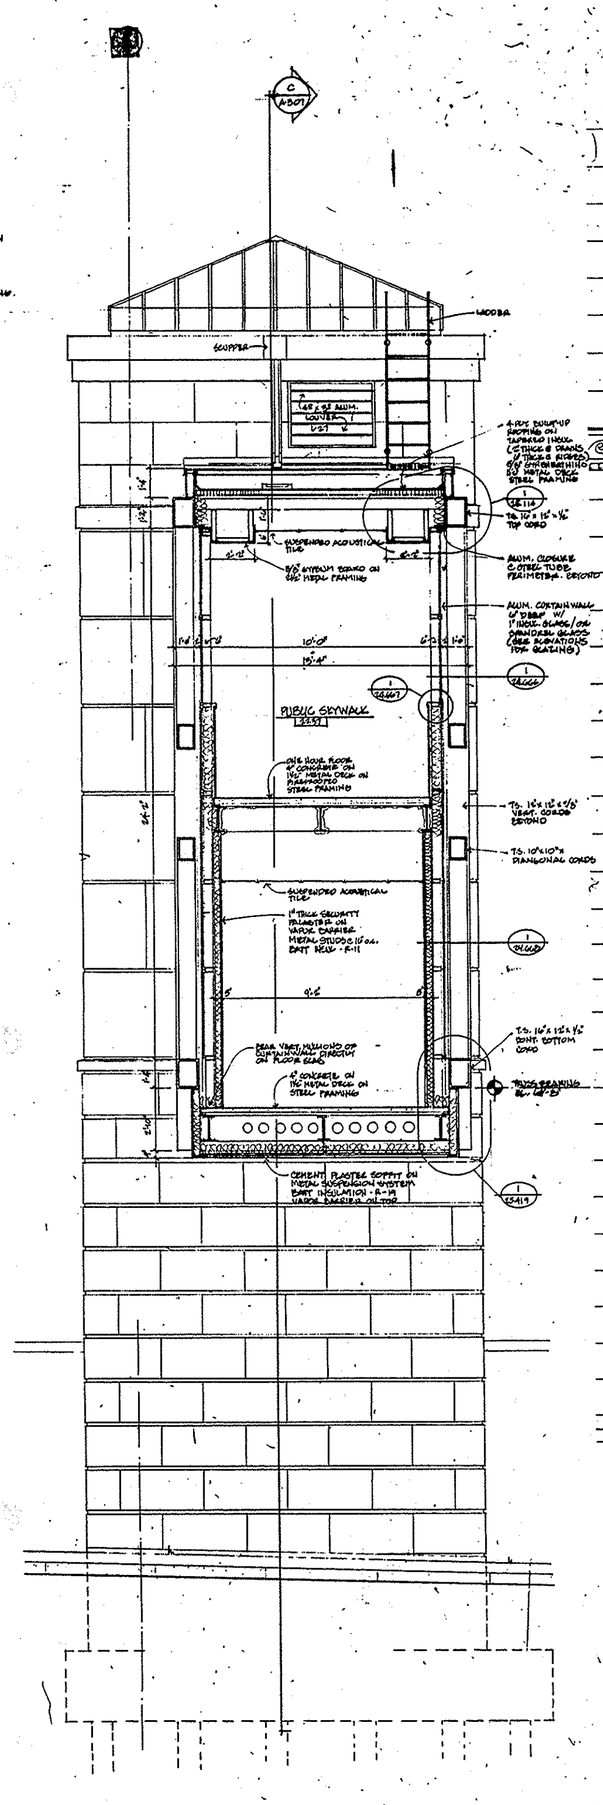

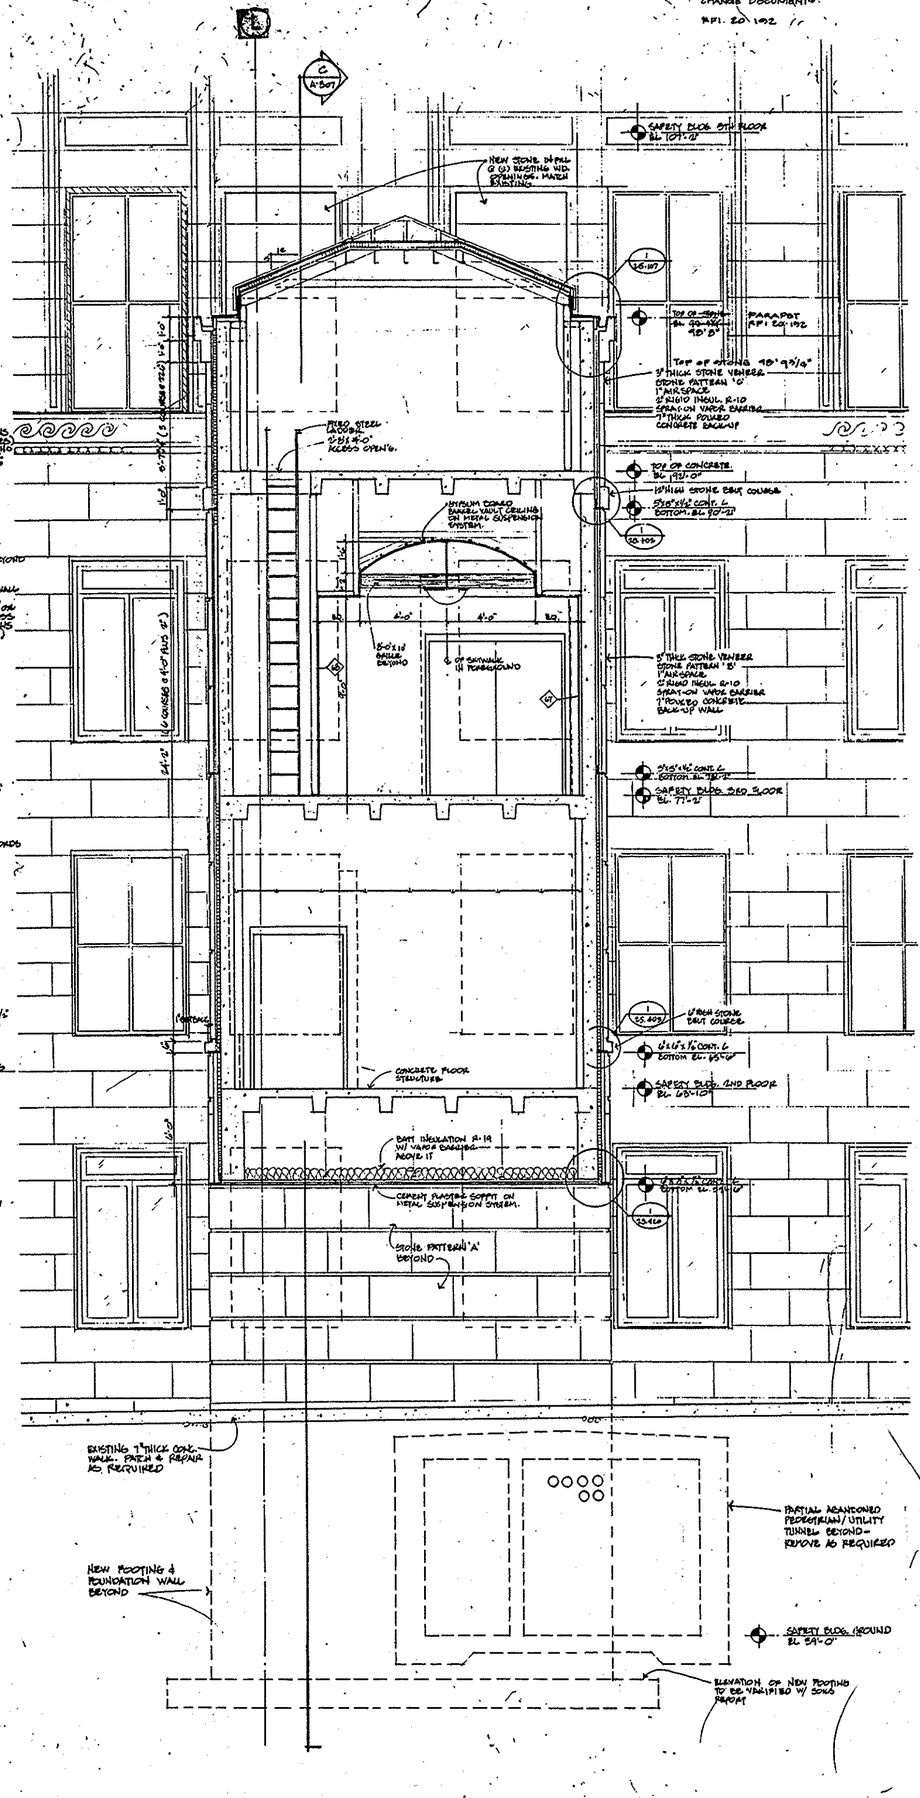

Joint Venture of:
Rte Zimmerman Design Group
Kahler Slater Architects
Architect Number 86003

Venture Architects

MILWAUKEE COUNTY DEPARTMENT OF PUBLIC WORKS
PROFESSIONAL SERVICES DIVISION
COURTHOUSE ANNEX 257 NORTH 15TH STREET MILWAUKEE, WISCONSIN 53233

REVISIONS
AS-BUILT

SCALE: 3/8" = 1'-0"
DRAWN BY:
CHECKED BY:
DATE: AUGUST 6, 1990

PROJECT TITLE: MILWAUKEE COUNTY JAIL & CRIMINAL JUSTICE FACILITY Wisconsin
SHEET DESCRIPTION: WALL SECTIONS

PROJECT NO. 01-4436

SHEET NO. A-307

FILE NO.

E-7-8

WALL SECTION – Center Skywalk Tower Looking North (C / A308) 3/8" = 1'-0"

WALL SECTION – Center Skywalk Tower Looking East (B / A308) 3/8" = 1'-0"

WALL SECTION – Skywalk @ Loading Dock (A / A308) 3/8" = 1'-0"

Venture Architects

Joint Venture of: the Zimmerman Design Group, Kahler Slater Torphy Architects
Architect Number 88003

MILWAUKEE COUNTY DEPARTMENT OF PUBLIC WORKS
PROFESSIONAL SERVICES DIVISION
COURTHOUSE ANNEX 907 NORTH 10TH STREET MILWAUKEE, WISCONSIN 53233

REVISIONS: AS-BUILT

DRAWN BY: | CHECKED BY:

SCALE: 3/8" = 1'-0"

DATE: AUGUST 5, 1991

PROJECT NO. 01-4436

PROJECT TITLE: MILWAUKEE COUNTY JAIL & CRIMINAL JUSTICE FACILITY, Milwaukee, Wisconsin

SHEET DESCRIPTION: WALL SECTIONS

SHEET NO. A-308

E-7-6

CHANGE DOCUMENTS
RFI 09-197
RFI 20-197

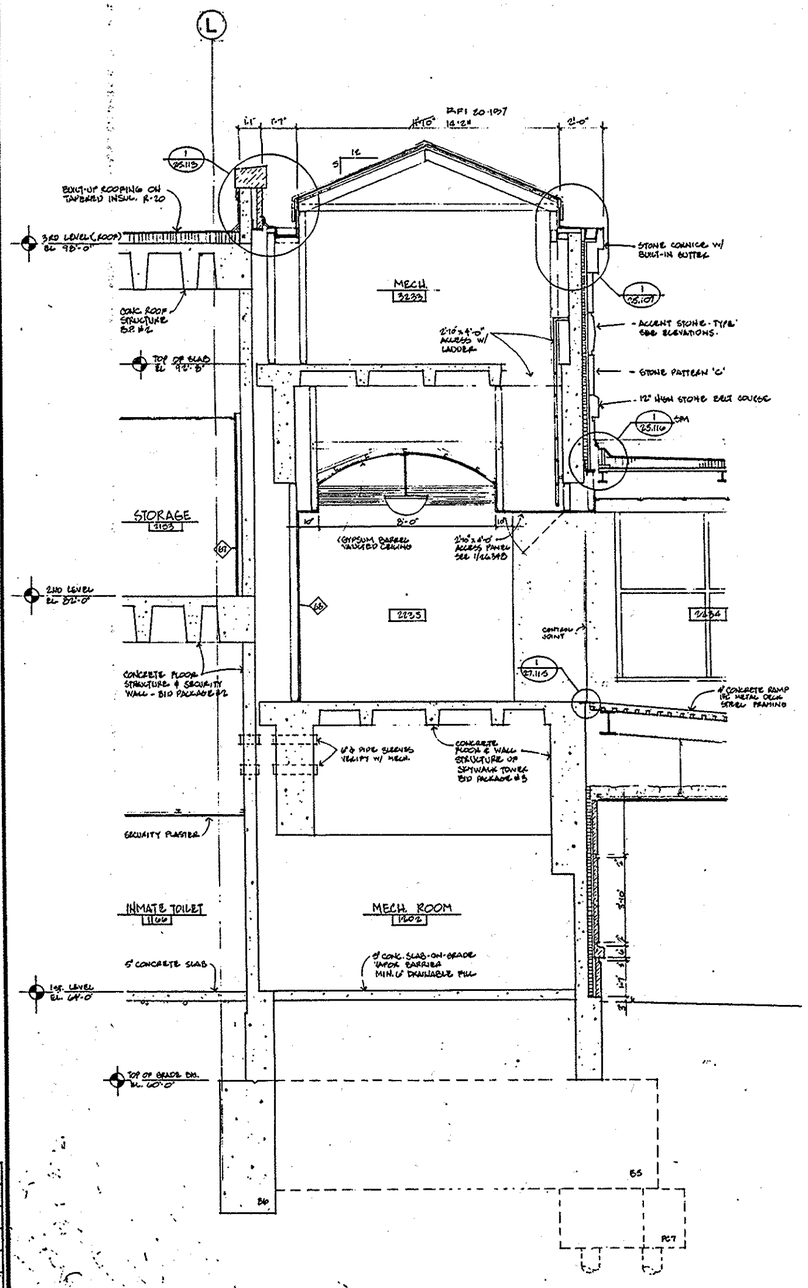

WALL SECTION – West Skywalk Tower Looking East
3/8" = 1'-0"
C A309

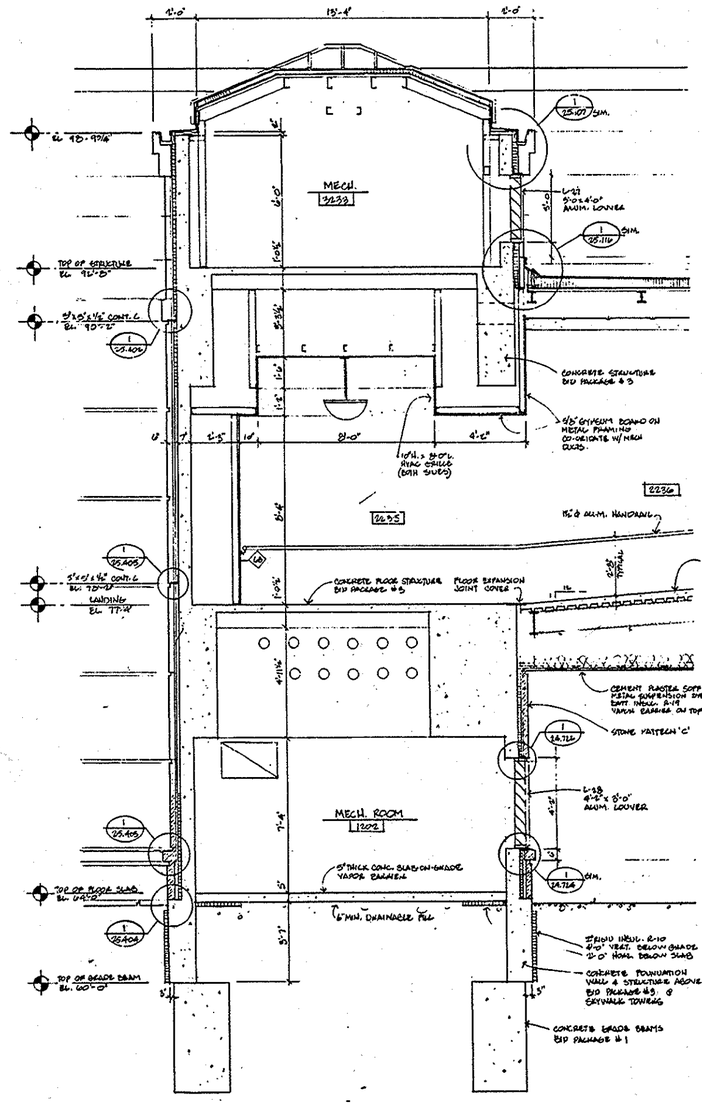

WALL SECTION – West Skywalk Tower Looking North
3/8" = 1'-0"
B A309

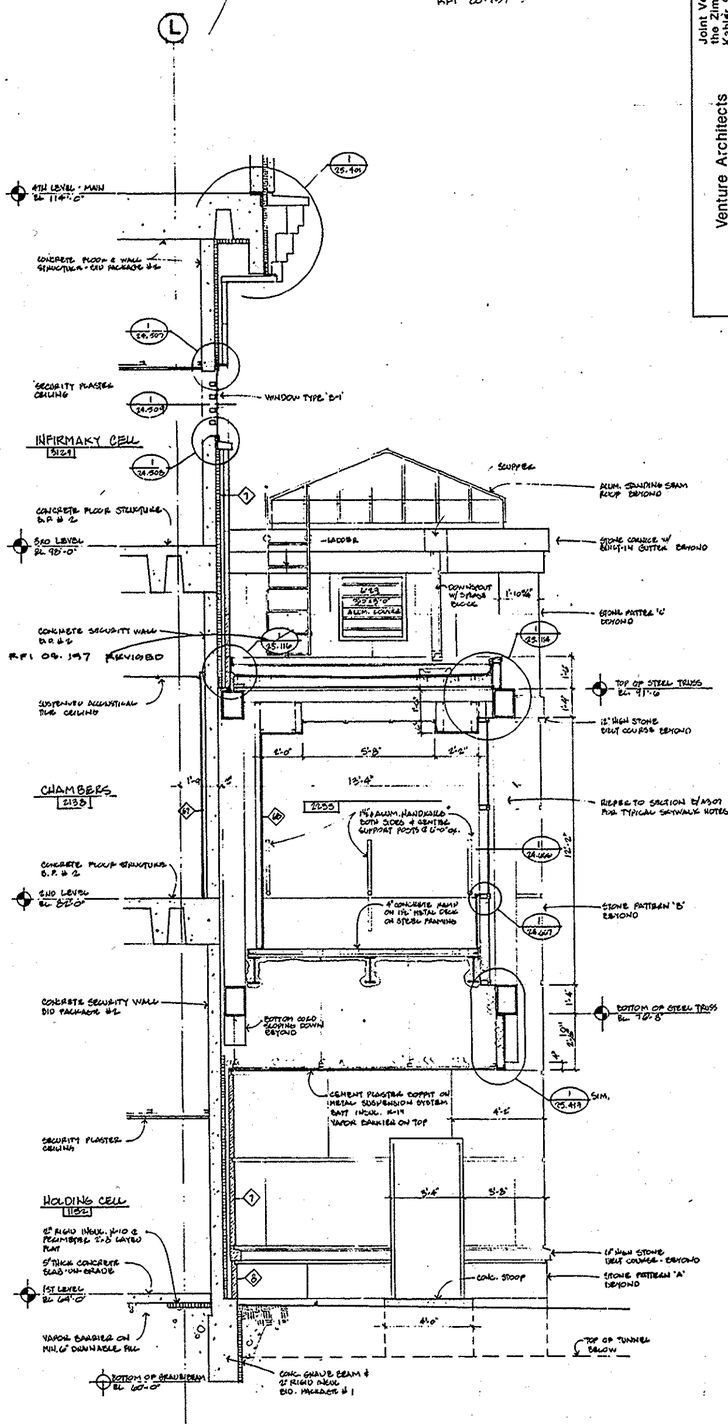

WALL SECTION – Skywalk To Courthouse Looking East
3/8" = 1'-0"
A A301

Joint Venture of:
the Zimmerman Design Group
Kahler Slater Torphy Architects
Architect Number 28003

Venture Architects

MILWAUKEE COUNTY DEPARTMENT OF PUBLIC WORKS
PROFESSIONAL SERVICES DIVISION
COURTHOUSE ANNEX 807 NORTH 16TH STREET MILWAUKEE, WISCONSIN 53233

REVISIONS
AS-BUILT

PROJECT TITLE: MILWAUKEE COUNTY JAIL & CRIMINAL JUSTICE FACILITY Wisconsin
SHEET DESCRIPTION: WALL SECTIONS
PROJECT NO. 01-4436
SHEET NO. A-309
FILE NO.
SCALE: 3/8" = 1'-0"
DATE: AUGUST 6, 1990
DRAWN BY:
CHECKED BY:

A-309

E-7-6

CHANGE DOCUMENTS:
CP 626

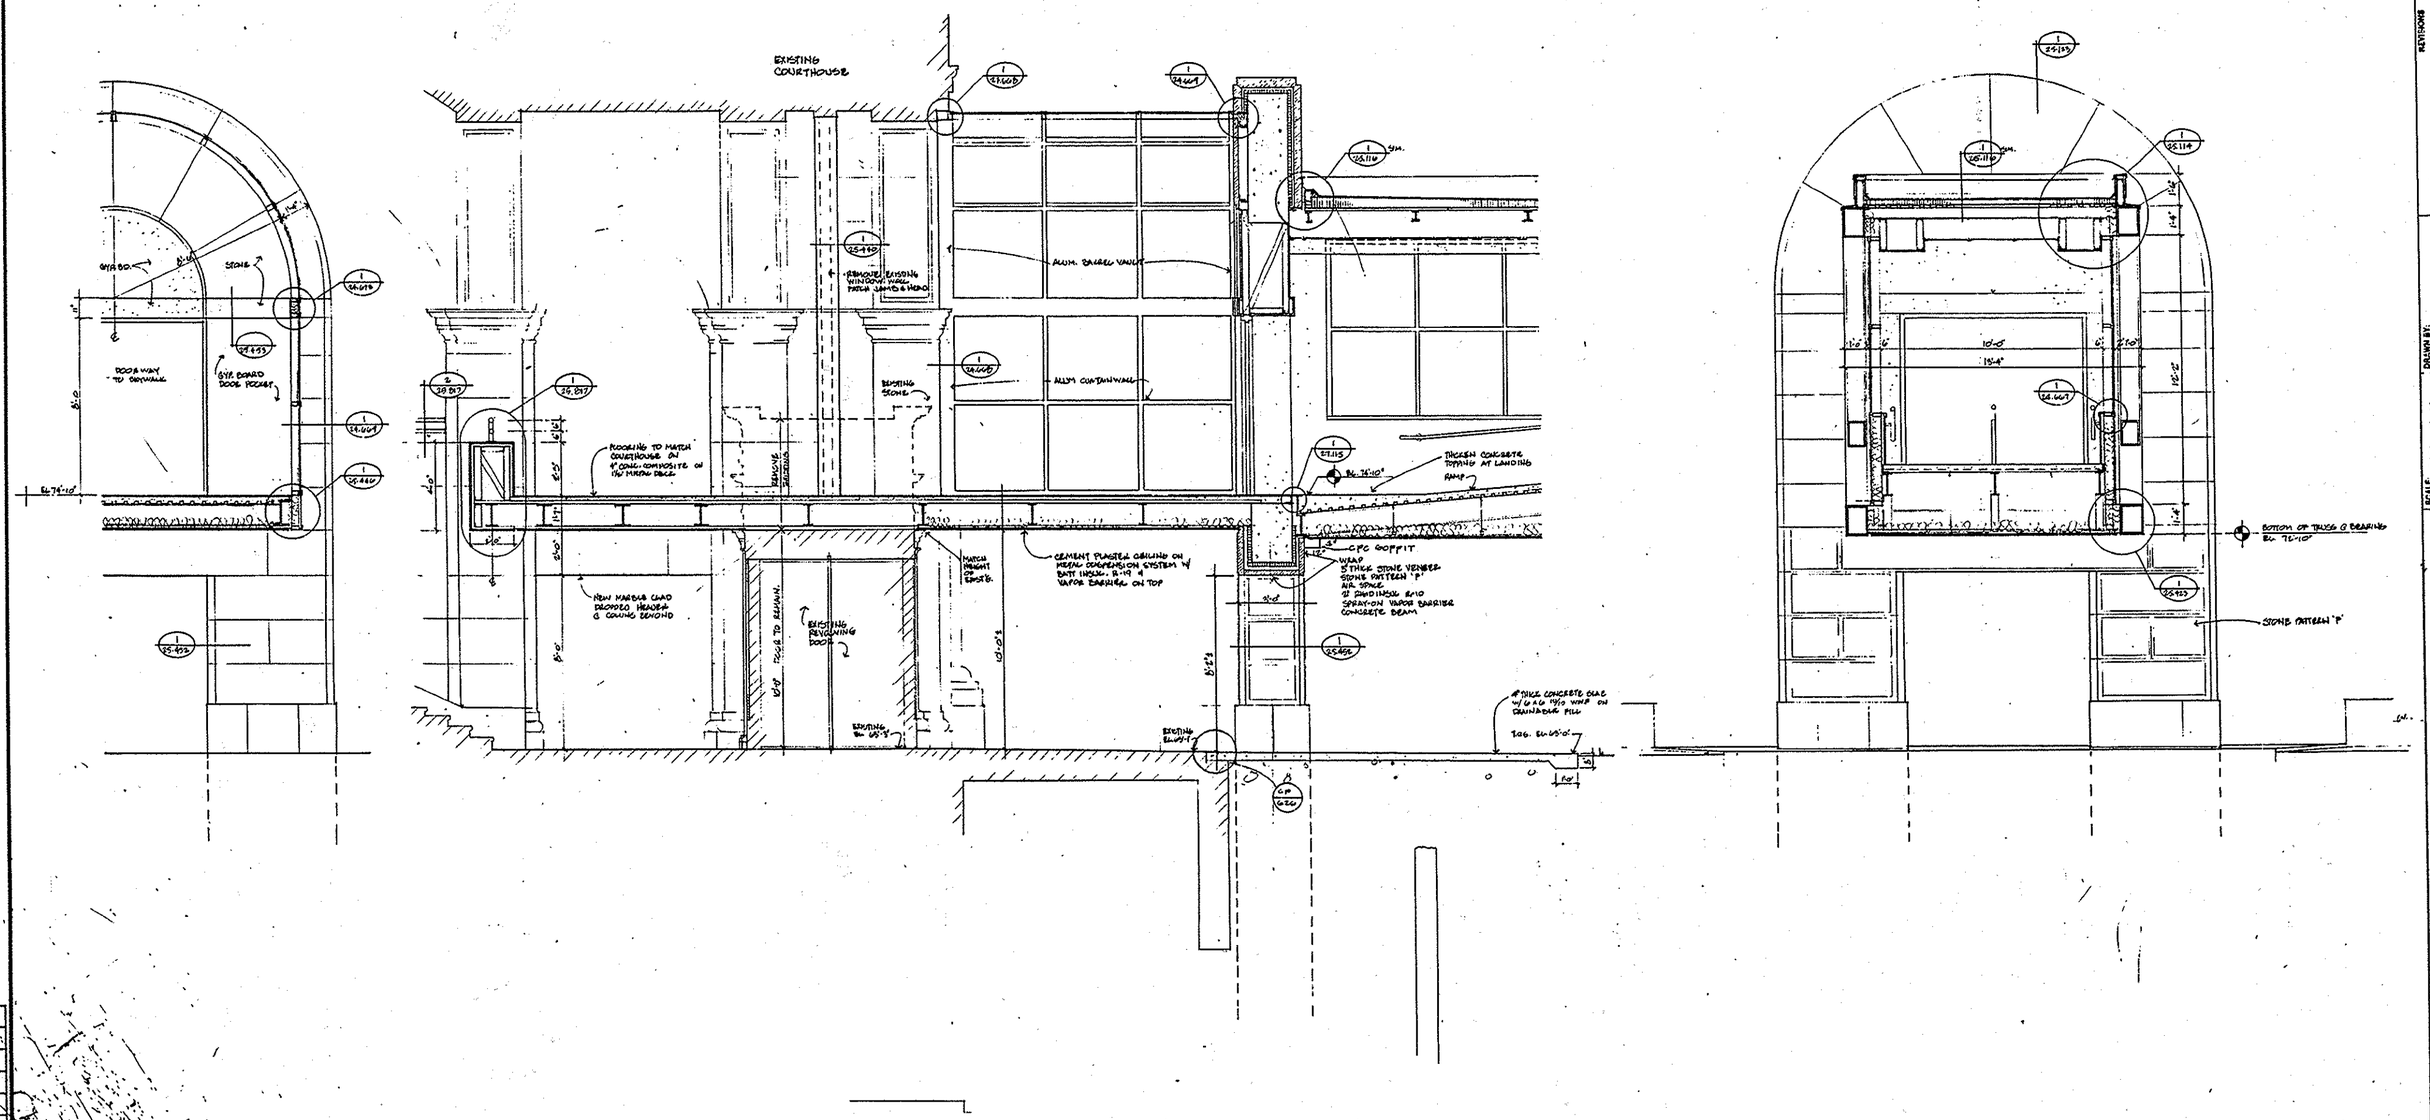

WALL SECTION – Barrel Vault Skywalk (C / A310)

WALL SECTION – Skywalk @ Courthouse Looking West (B / A310)

WALL SECTION – Skywalk To Courthouse Looking South (A / A310)

Venture Architects

Joint Venture of:
the Zimmerman Design Group
Kahler Slater Torphy Architects
Architect Number 88003

MILWAUKEE COUNTY DEPARTMENT OF PUBLIC WORKS
PROFESSIONAL SERVICES DIVISION
COURTHOUSE ANNEX 907 NORTH 10TH STREET MILWAUKEE, WISCONSIN 53233

REVISIONS: AS-BUILT

DRAWN BY:
CHECKED BY:
SCALE: 3/8" = 1'-0"
DATE: AUGUST 6, 1990

PROJECT TITLE: MILWAUKEE COUNTY JAIL & CRIMINAL JUSTICE FACILITY
Milwaukee Wisconsin
SHEET DESCRIPTION: WALL SECTIONS

PROJECT NO. 01-4436

SHEET NO. A-310

E-7-6

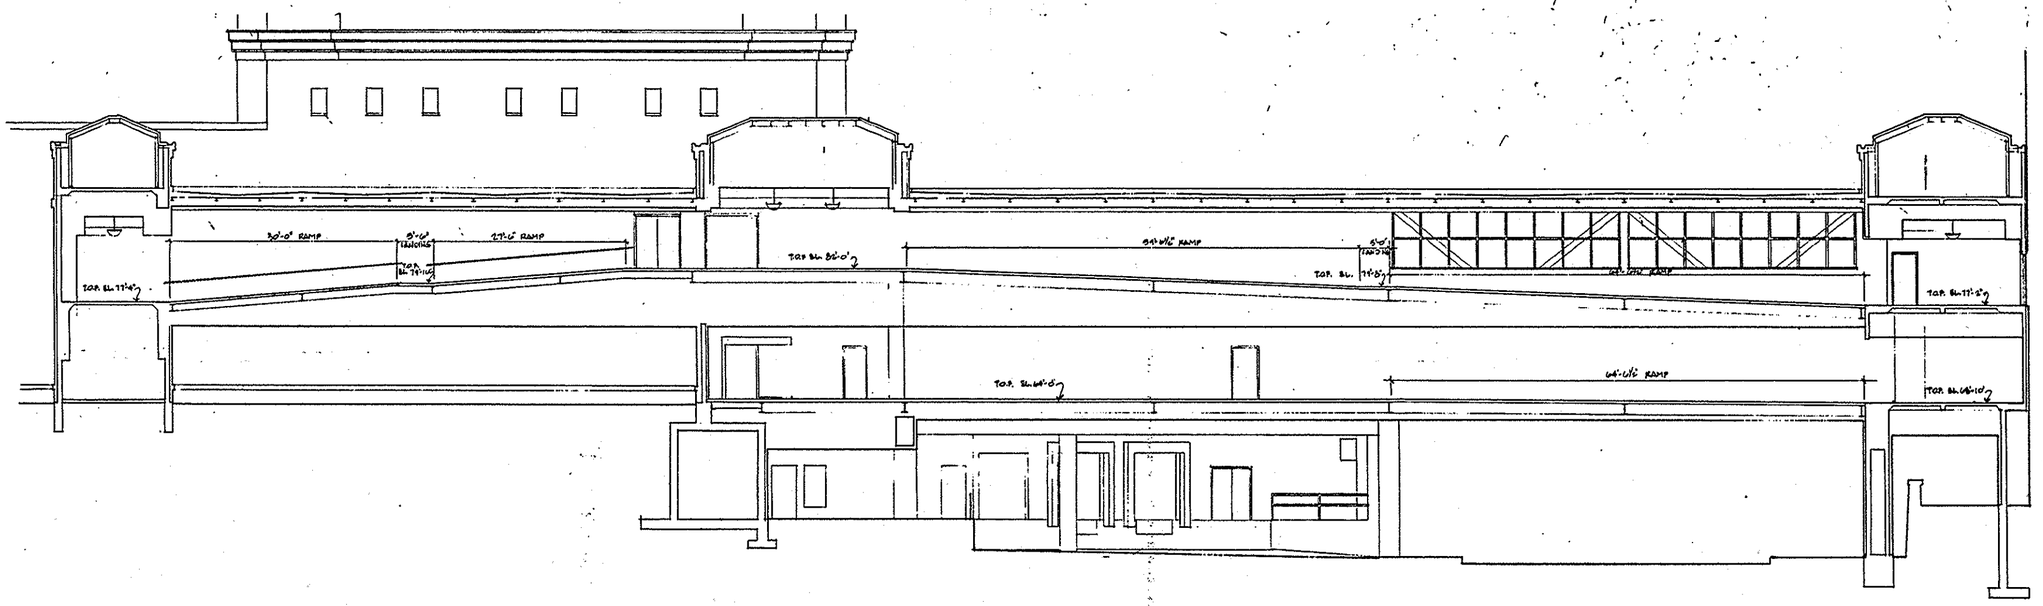

BUILDING SECTION THRU SKYWALK 1/8" = 1'-0" (1/A311)

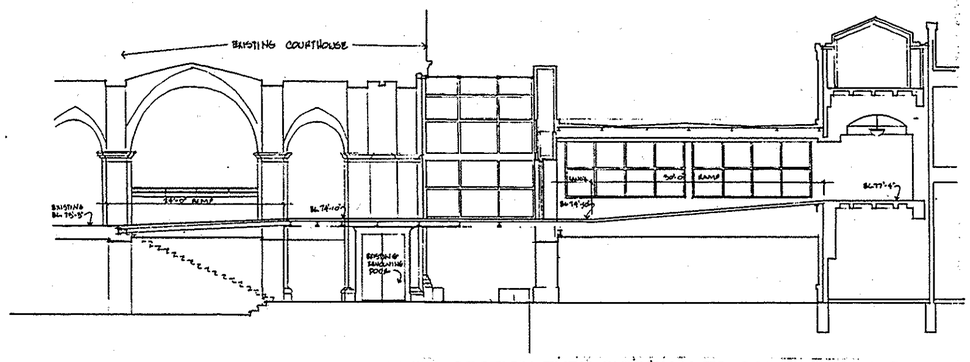

BUILDING SECTION THRU SKYWALK TO COURTHOUSE 1/8" = 1'-0" (2/A311)

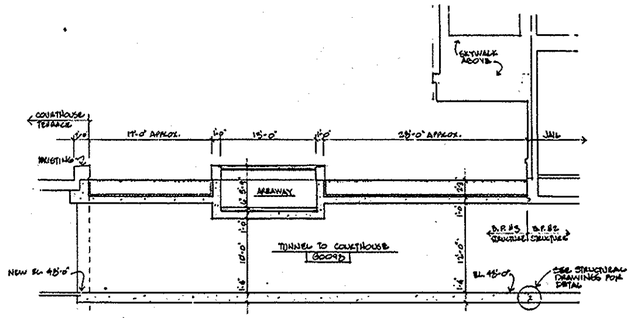

BUILDING SECTION THRU TUNNEL TO COURTHOUSE 1/8" = 1'-0" (3/A311)

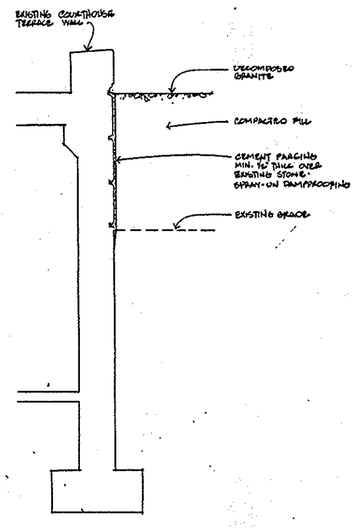

EXISTING TERRACE WALL 1/8" = 1'-0" (D/A311)

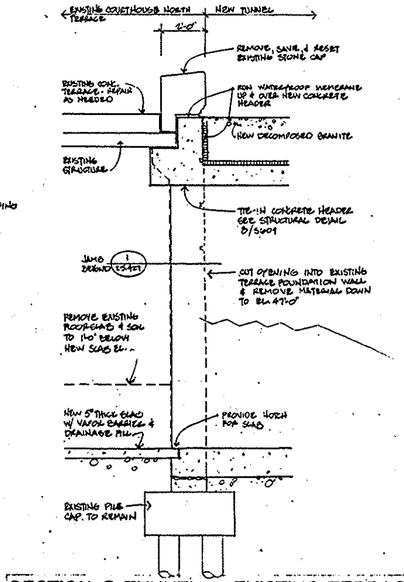

SECTION @ TUNNEL at EXISTING TERRACE 1/8" = 1'-0" (C/A311)

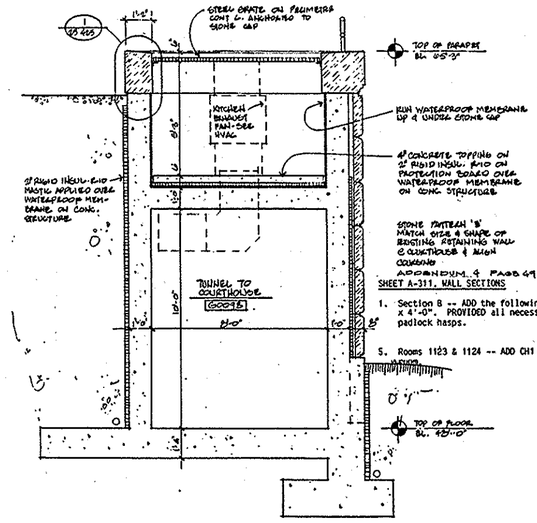

ADDENDUM 4 PAGE 49:
SHEET A-311, WALL SECTIONS

1. Section B -- ADD the following: Provide a hinged grating panel, 3'-0" x 4'-0". PROVIDED all necessary steel angles to support opening and padlock hasps.

5. Rooms 1123 & 1124 -- ADD CH1 on West wall and NR1 on East wall of each

SECTION THRU AREAWAY (B/A311)

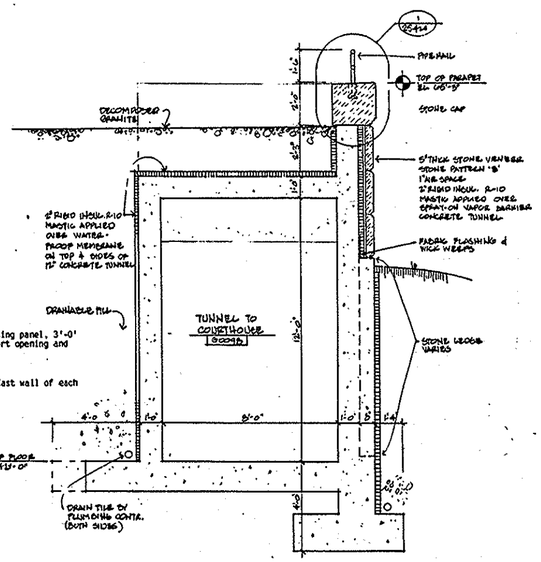

SECTION THRU TUNNEL 1/8" = 1'-0" (A/A311)

Joint Venture of:
Venture Architects
Kahler Slater Torphy Architects
Architect Number 88003

MILWAUKEE COUNTY DEPARTMENT OF PUBLIC WORKS
PROFESSIONAL SERVICES DIVISION
COURTHOUSE ANNEX 907 NORTH 10TH STREET MILWAUKEE, WISCONSIN 53233

REVISIONS
AS-BUILT

DRAWN BY:
CHECKED BY:
SCALE: 3/8" = 1'-0"
DATE: August 4, 1993

PROJECT TITLE:
MILWAUKEE COUNTY JAIL & CRIMINAL JUSTICE FACILITY
Milwaukee, Wisconsin
WALL SECTIONS

PROJECT NO. 01-4438

SHEET NO. A-341