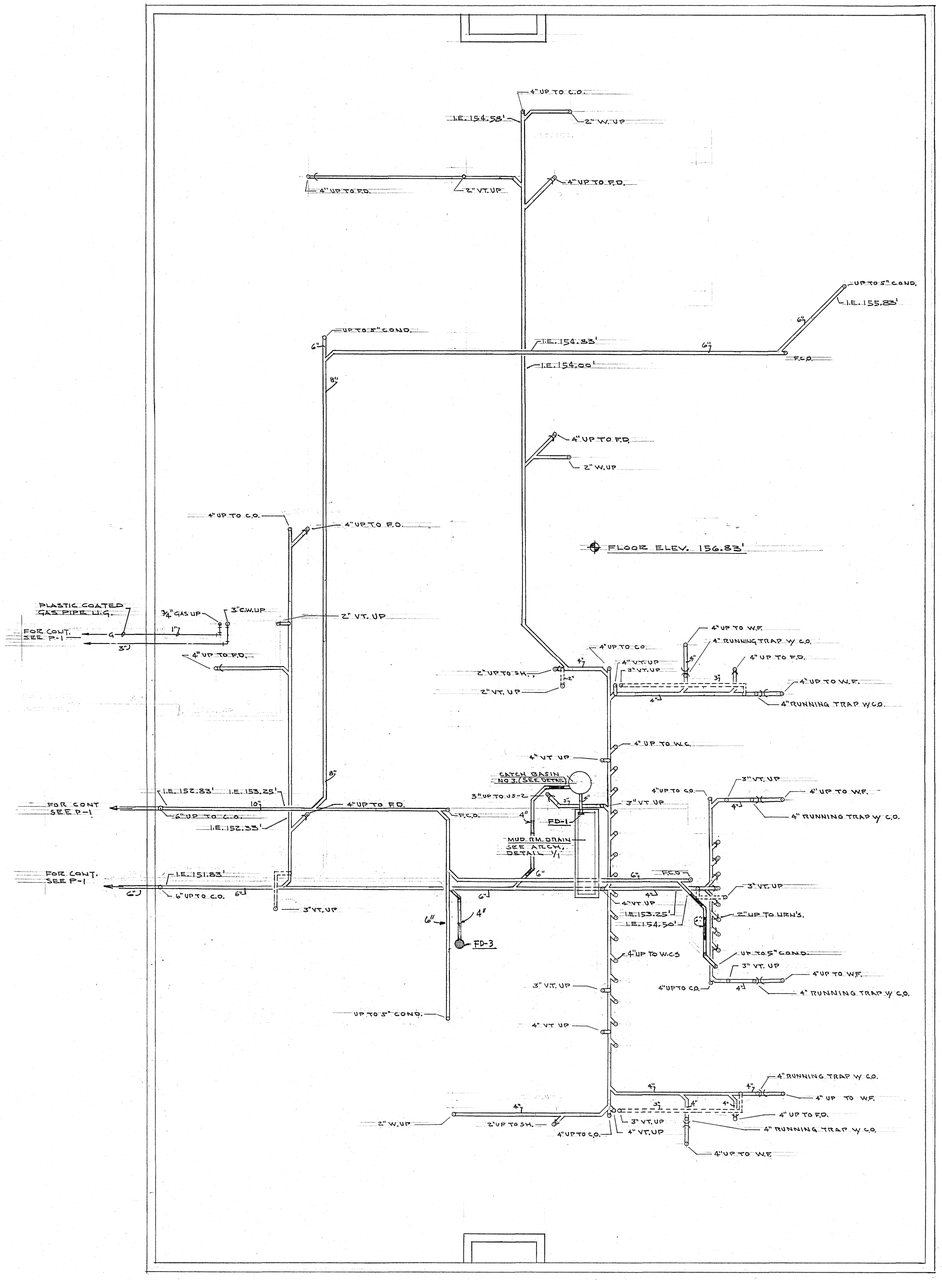

FOUNDATION PLAN

UNIT "F" SCALE: 1/8" = 1'-0"

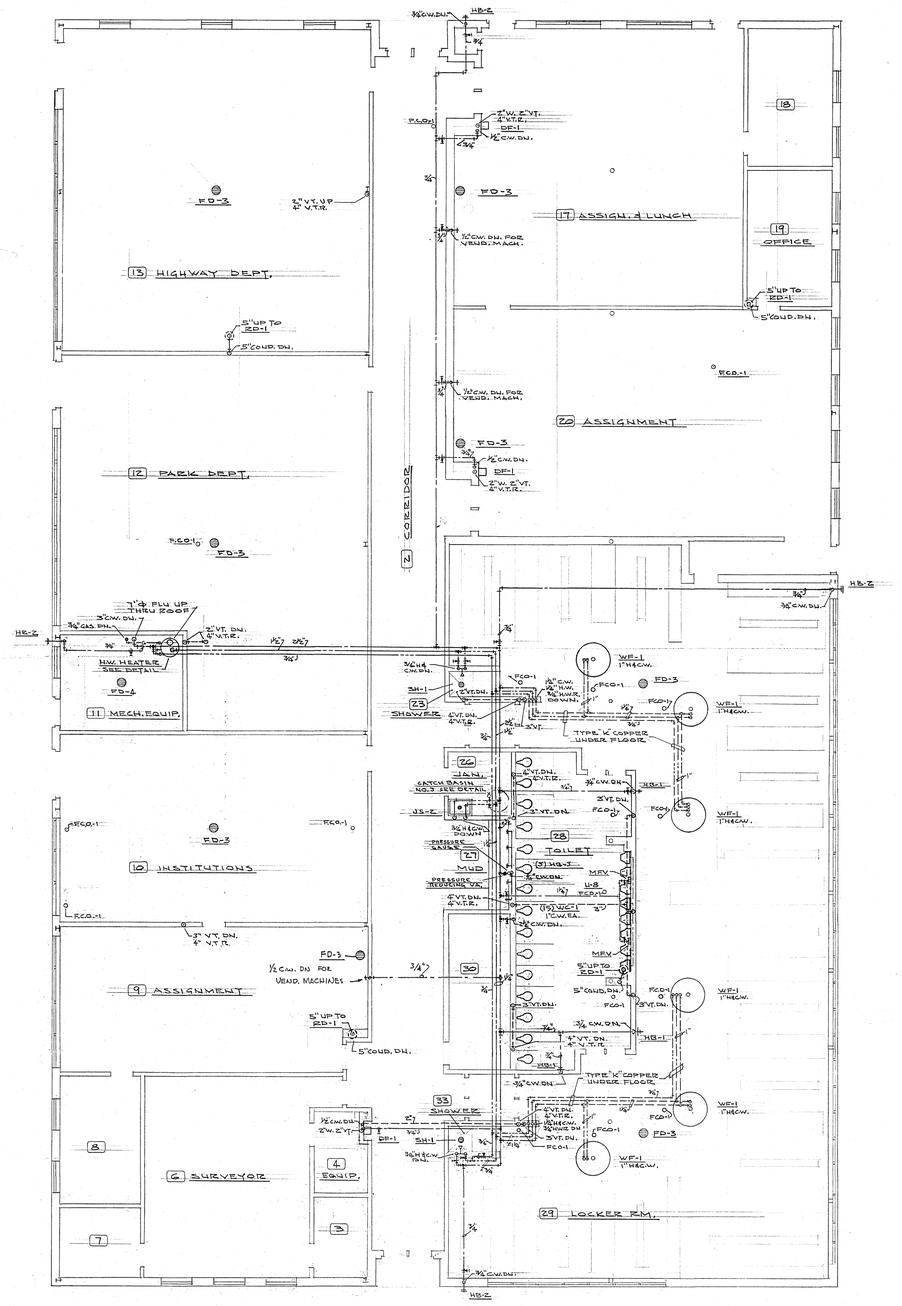

FOREMANS SHOP FLOOR PLAN

UNIT "F" SCALE: 1/8" = 1'-0"

N

AS-BUILT DRAWING

DATE 7-22-70

PLUMBING

UNIT "F" FLOOR - FND. PLAN 1/8" = 1'-0"

CENTRAL GARAGE FACILITY
FOR
MILWAUKEE COUNTY
10320 WATERTOWN PLANK ROAD
WAUWATOSA, WISCONSIN

JOB 554	WILLIAM P. KRAMER ARCHITECT 611 NORTH BROADWAY MILWAUKEE, WISCONSIN	DWG P 2. OF	
DATE 15-11-66		REV. 7	

RING & DUCHATEAU, INC. - CONSULTING ENGINEERS

35609 [redacted] 02-E-10-003

32