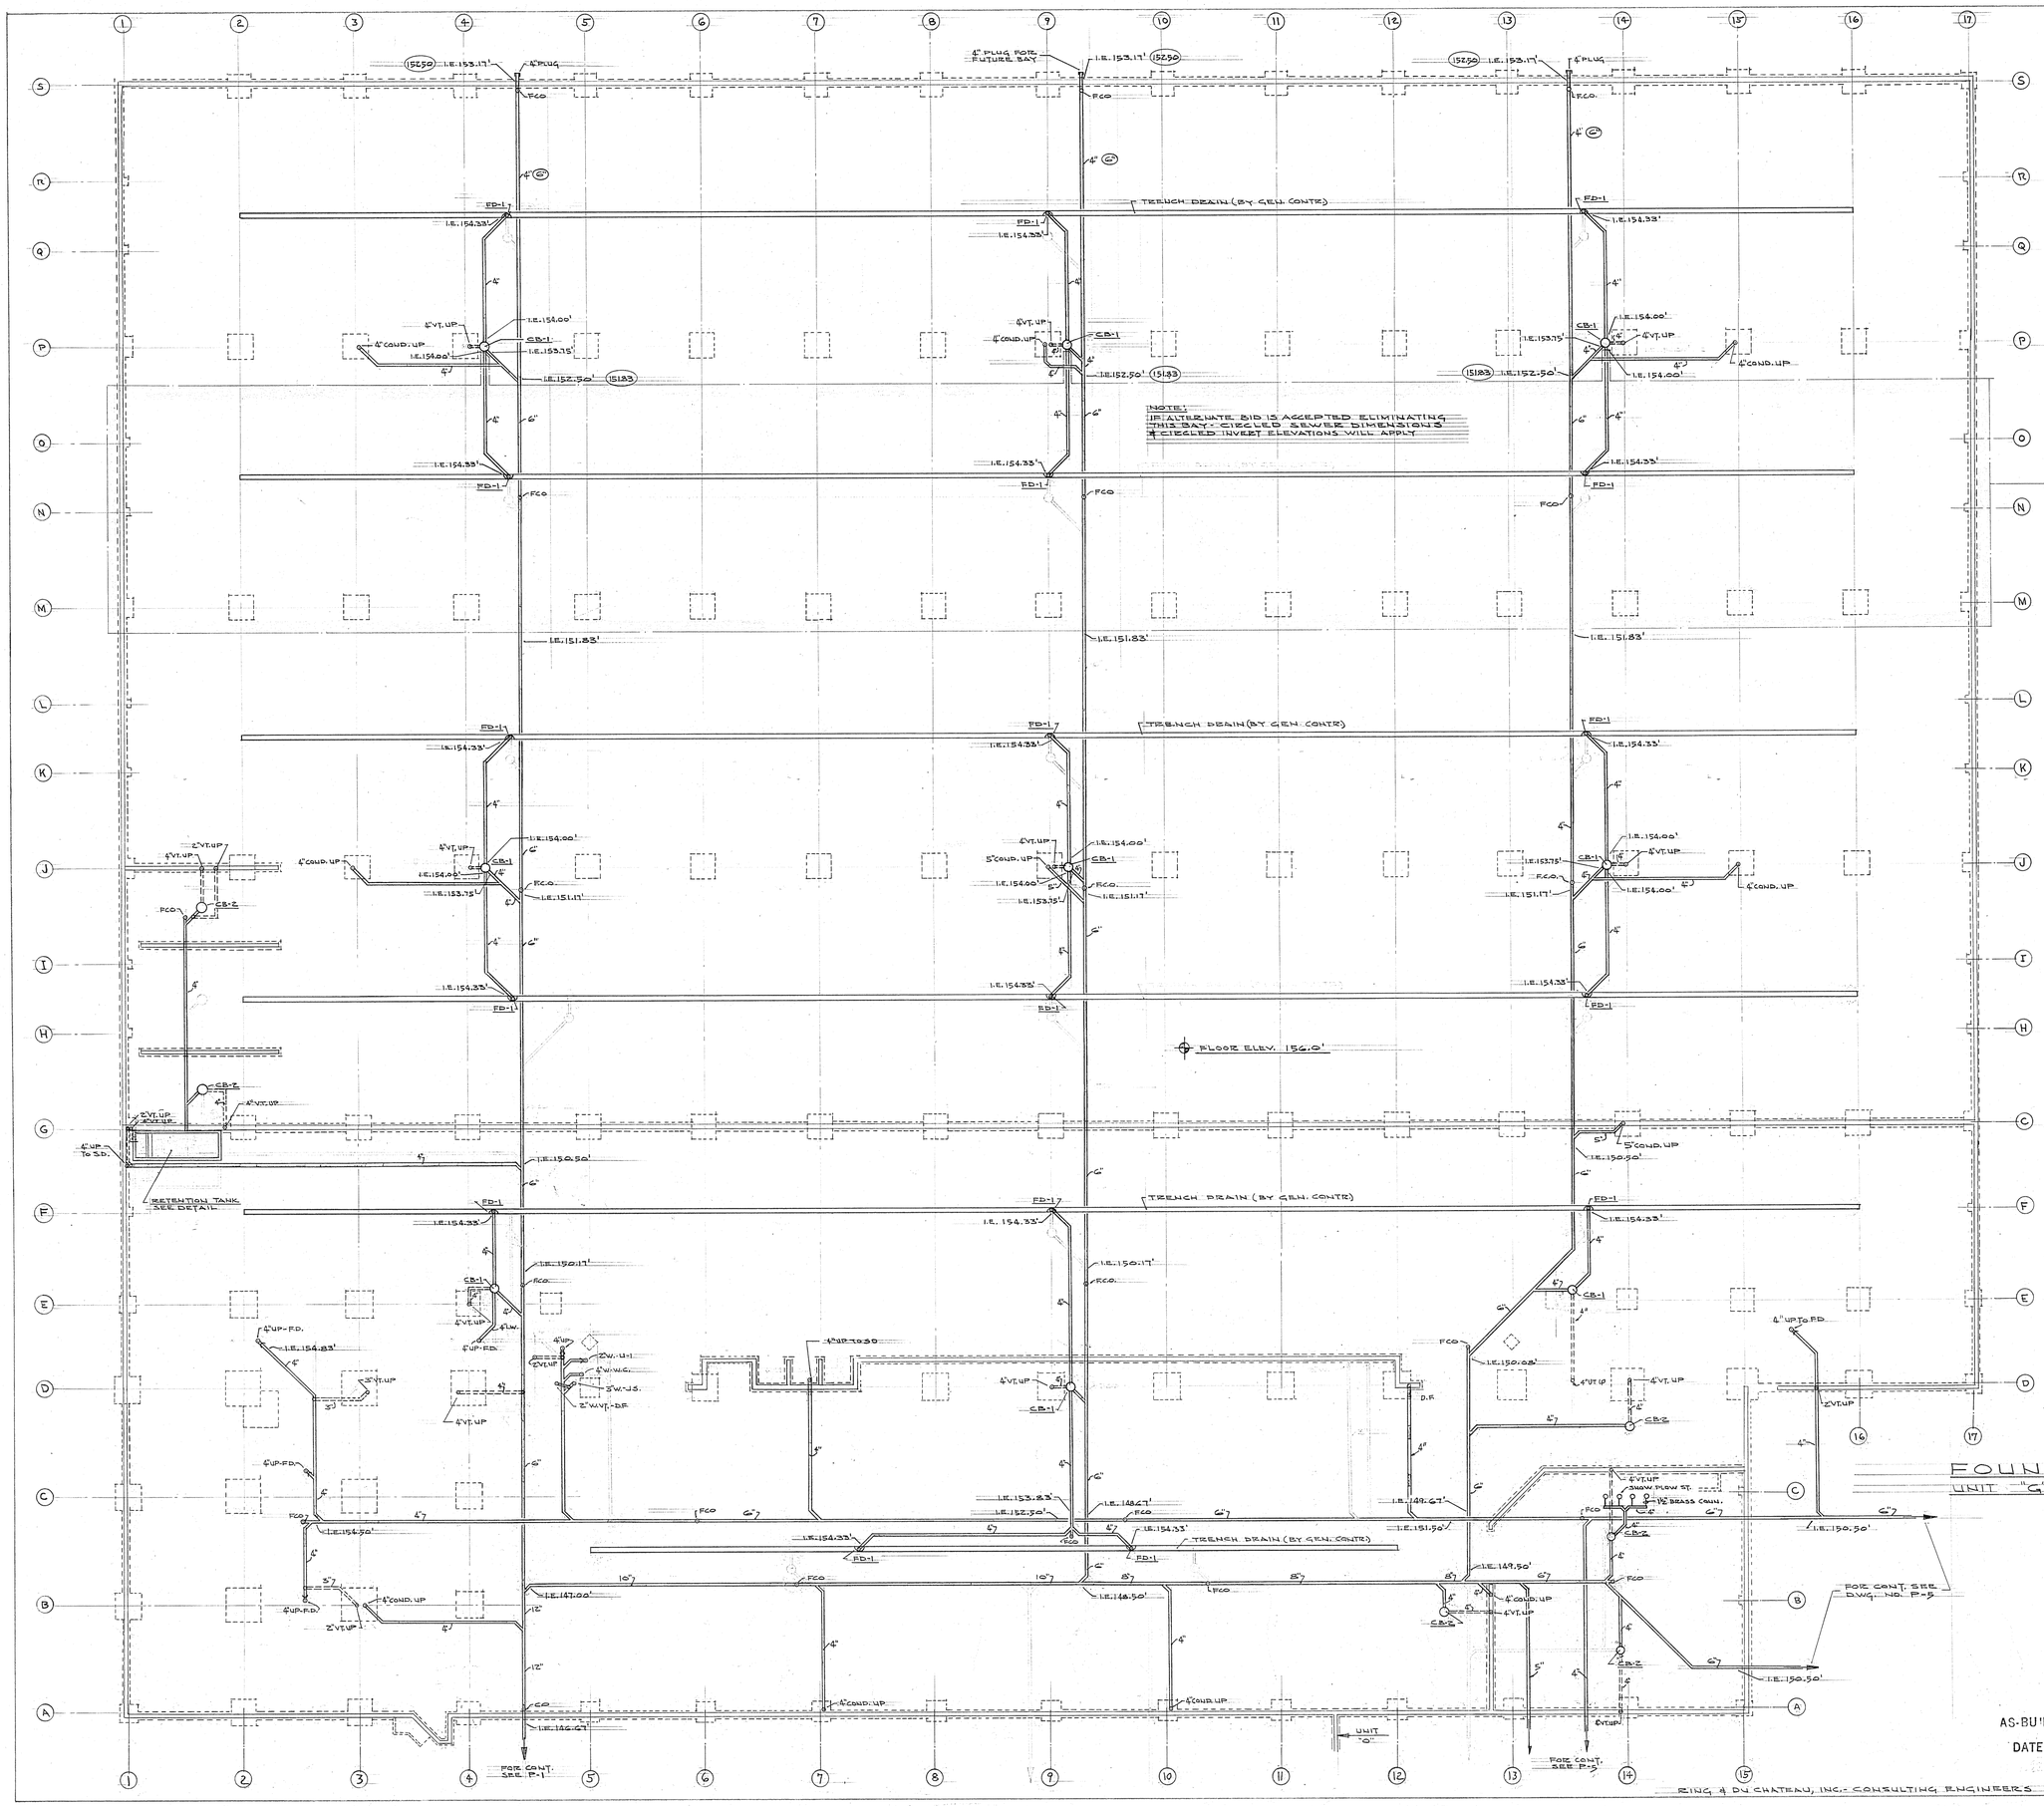

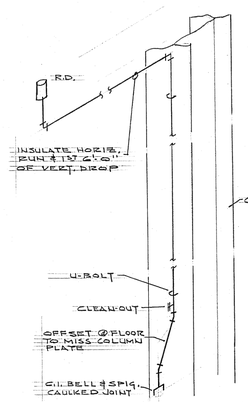

RAIN CONDUCTOR DETAIL
NO SCALE

FOUNDATION PLAN
UNIT "G" SCALE: 1/2"=1'-0"

PLUMBING
UNIT "G" FOUNDATION PLAN 1/16" 1' 0"

AS-BUILT DRAWING
DATE 7-22-70

CENTRAL GARAGE FACILITY
FOR
MILWAUKEE COUNTY
10320 WATERTOWN PLANK ROAD
WAUWATOSA, WISCONSIN

JOB 554	WILLIAM P. KRAMER ARCHITECT 611 NORTH BROADWAY MILWAUKEE, WISCONSIN	DWG P-3	OF 7
DATE 15-11-66		REV	

RING & DU CHATEAU, INC. - CONSULTING ENGINEERS

35607 02-E-10-068 [redacted]