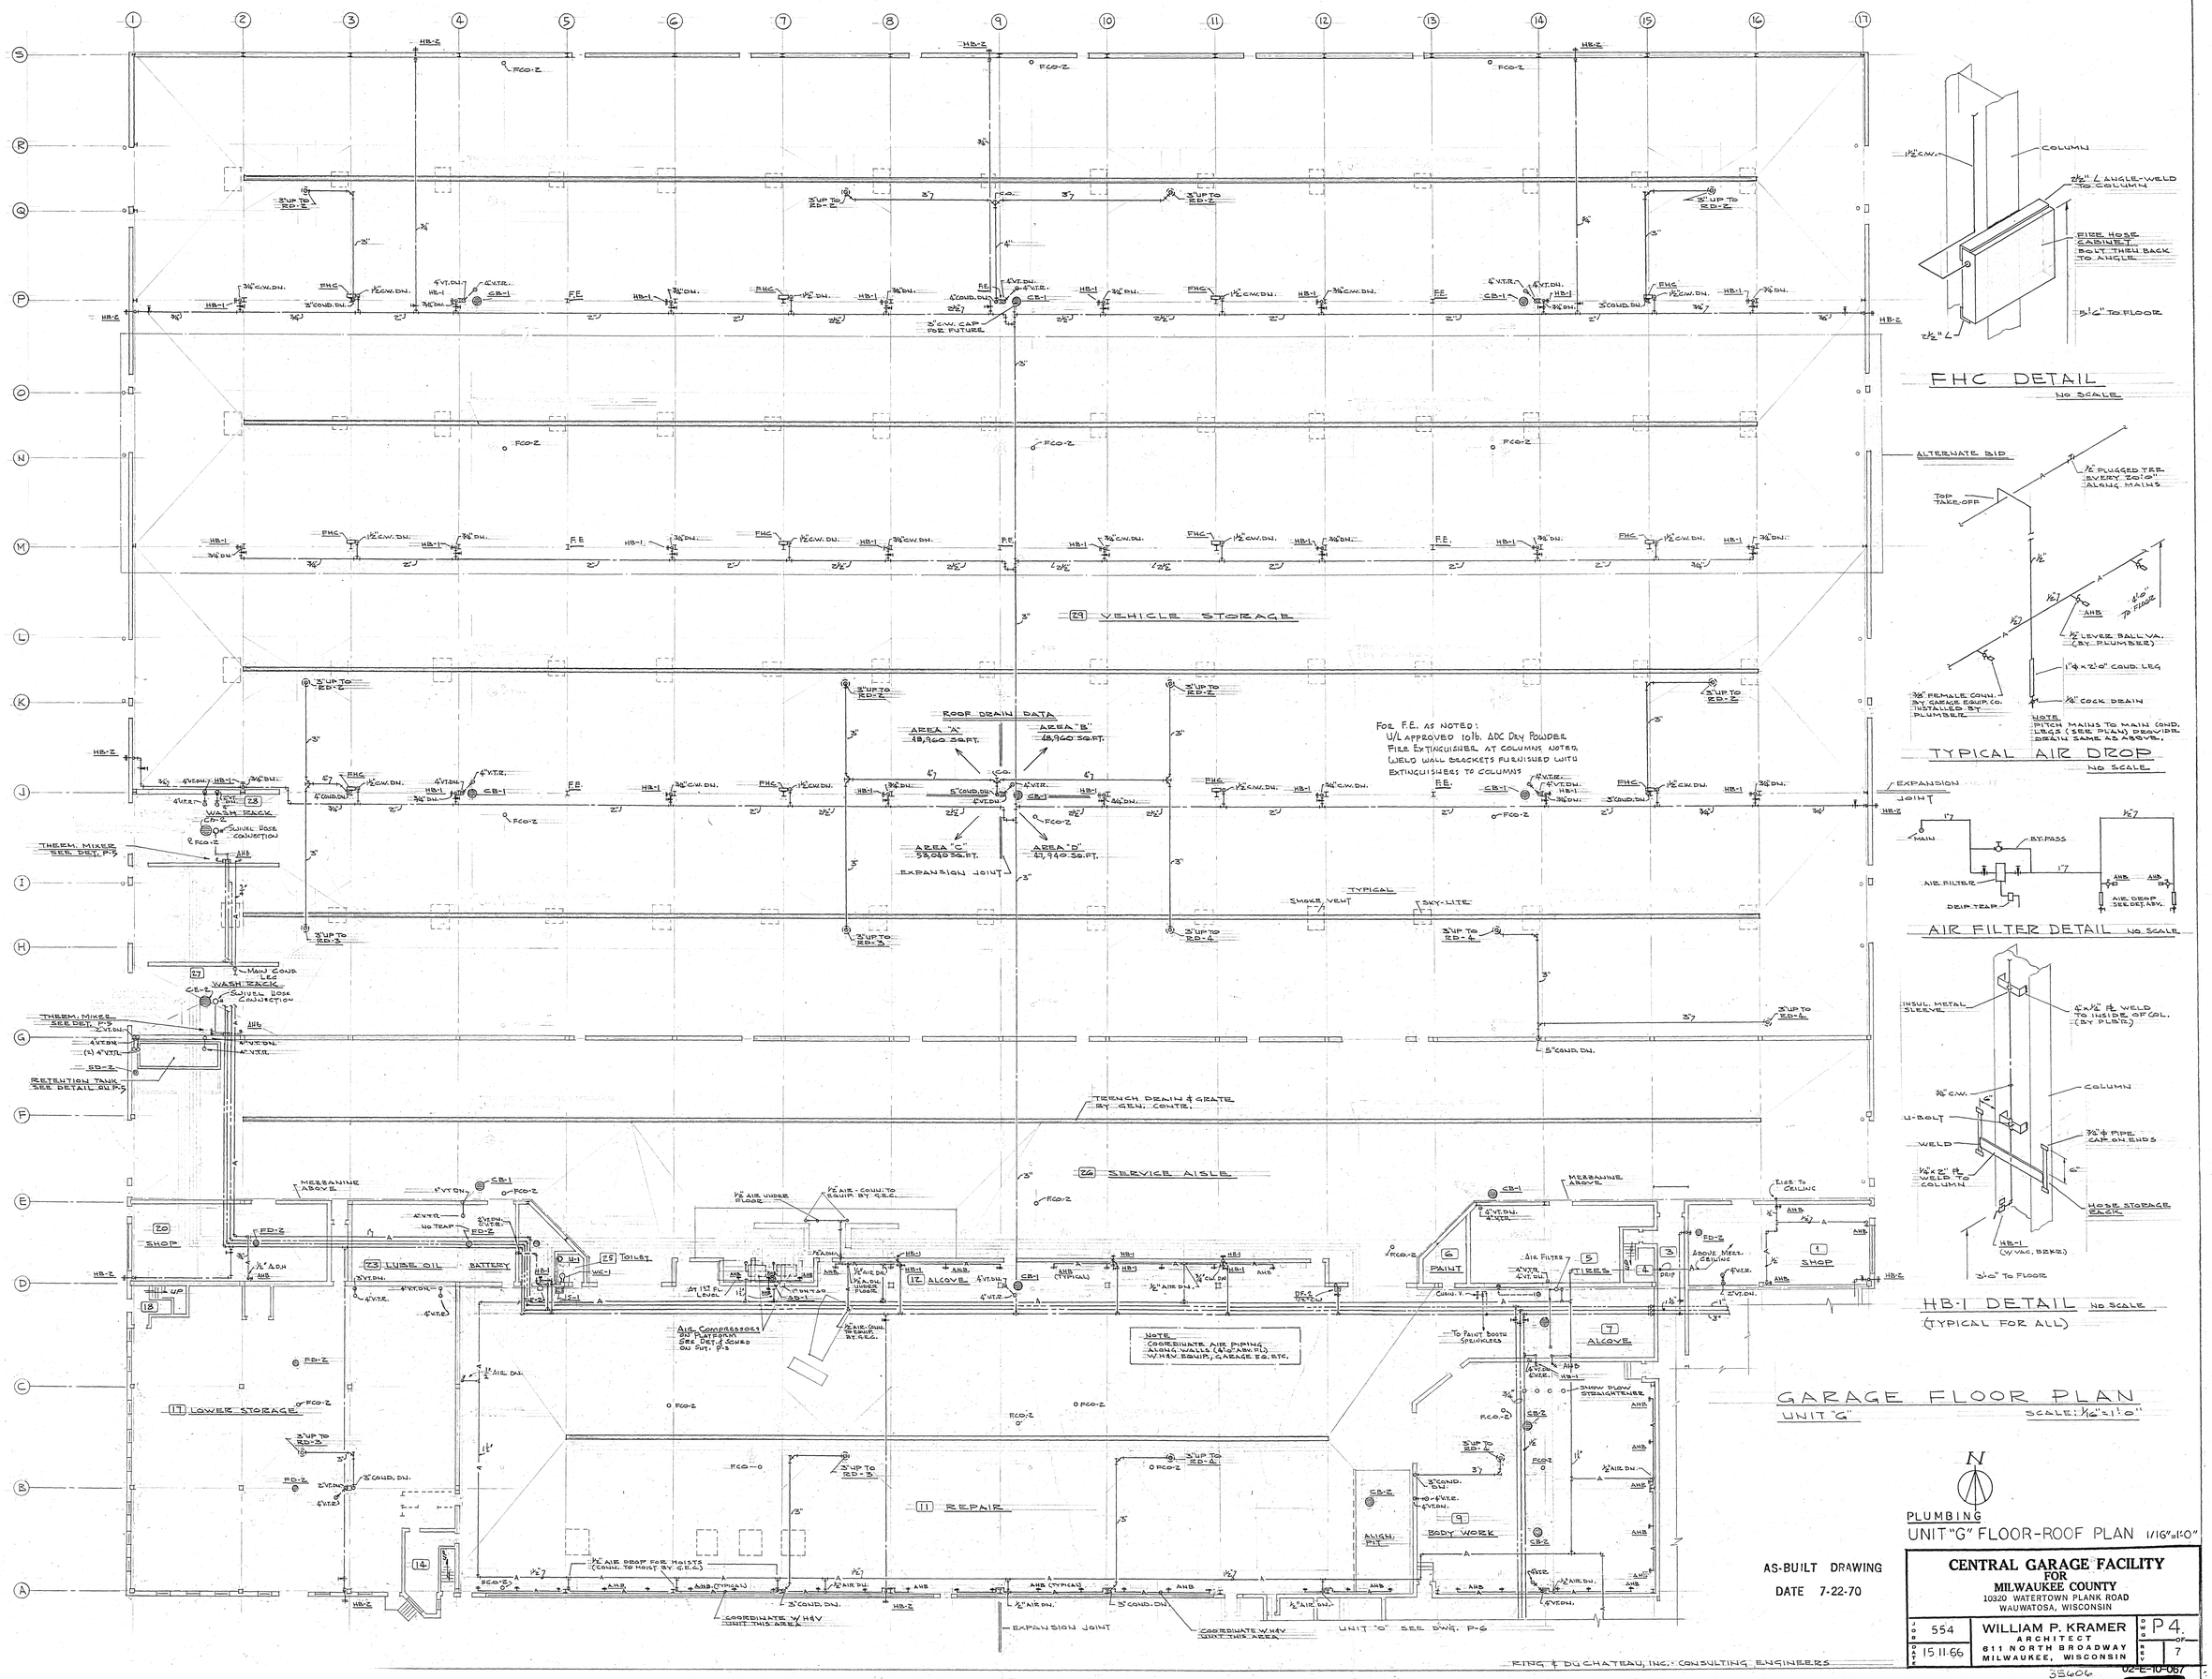

VEHICLE STORAGE
SERVICE AISLE
LOWER STORAGE
REPAIR
SHOP
LUBE OIL
BATTERY
TOILET
ALCOVE
PAINT
TIRES
BODY WORK
WASH RACK
ROOF DRAIN DATA
AREA "A" 48,960 SQ.FT.
AREA "B" 48,960 SQ.FT.
AREA "C" 53,040 SQ.FT.
AREA "D" 47,940 SQ.FT.
EXPANSION JOINT
TYPICAL
SMOKE VENT
SKY-LITE
TRENCH DRAIN & GRATE BY GEN. CONTR.
FOR F.E. AS NOTED:
U/L APPROVED 10lb. ADC DRY POWDER
FIRE EXTINGUISHER AT COLUMNS NOTED.
WELD WALL BRACKETS FURNISHED WITH
EXTINGUISHERS TO COLUMNS
NOTE
COORDINATE AIR PIPING
ALONG WALLS (4'-0" ABV. FL.)
W/ H&V EQUIP., GARAGE EQ. ETC.
FHC DETAIL
NO SCALE
TYPICAL AIR DROP
NO SCALE
AIR FILTER DETAIL NO SCALE
HB-1 DETAIL NO SCALE
(TYPICAL FOR ALL)
GARAGE FLOOR PLAN
UNIT "G"
SCALE: 1/16"=1'-0"
PLUMBING
UNIT "G" FLOOR-ROOF PLAN 1/16"=1'-0"
AS-BUILT DRAWING
DATE 7-22-70
CENTRAL GARAGE FACILITY
FOR
MILWAUKEE COUNTY
10320 WATERTOWN PLANK ROAD
WAUWATOSA, WISCONSIN
WILLIAM P. KRAMER
ARCHITECT
611 NORTH BROADWAY
MILWAUKEE, WISCONSIN
JOB 554
DATE 15 11 66
DWG P4
REV 7
RING & DUCHATEAU, INC. CONSULTING ENGINEERS
35606
02-E-10-067