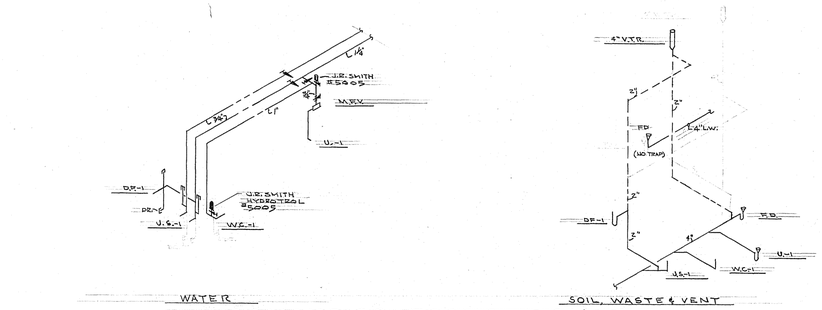

WATER — SOIL, WASTE & VENT

ISOMETRICS ROOMS NO. 24 & 25

UNIT-"G" — NO SCALE

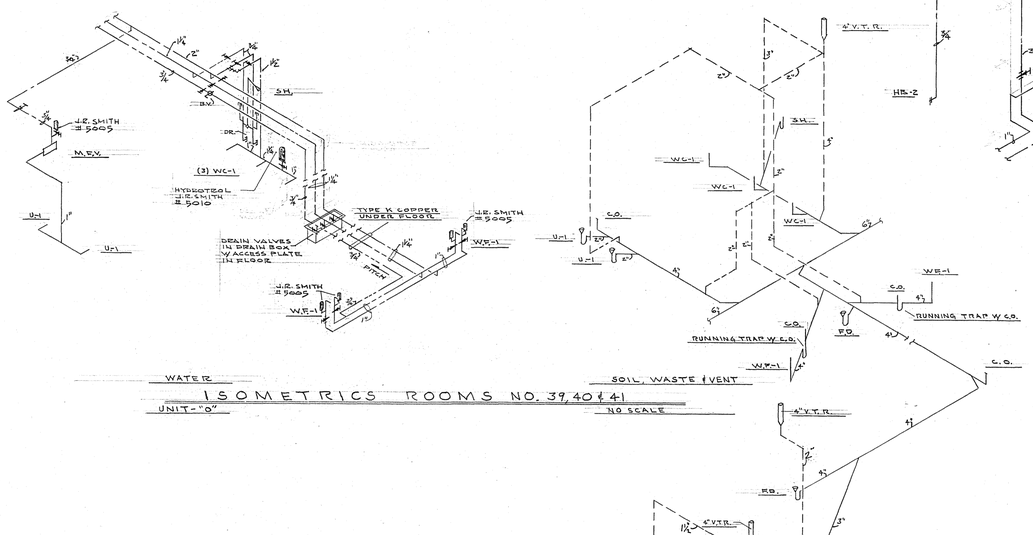

WATER — SOIL, WASTE & VENT

ISOMETRICS ROOMS NO. 39, 40 & 41

UNIT-"O" — NO SCALE

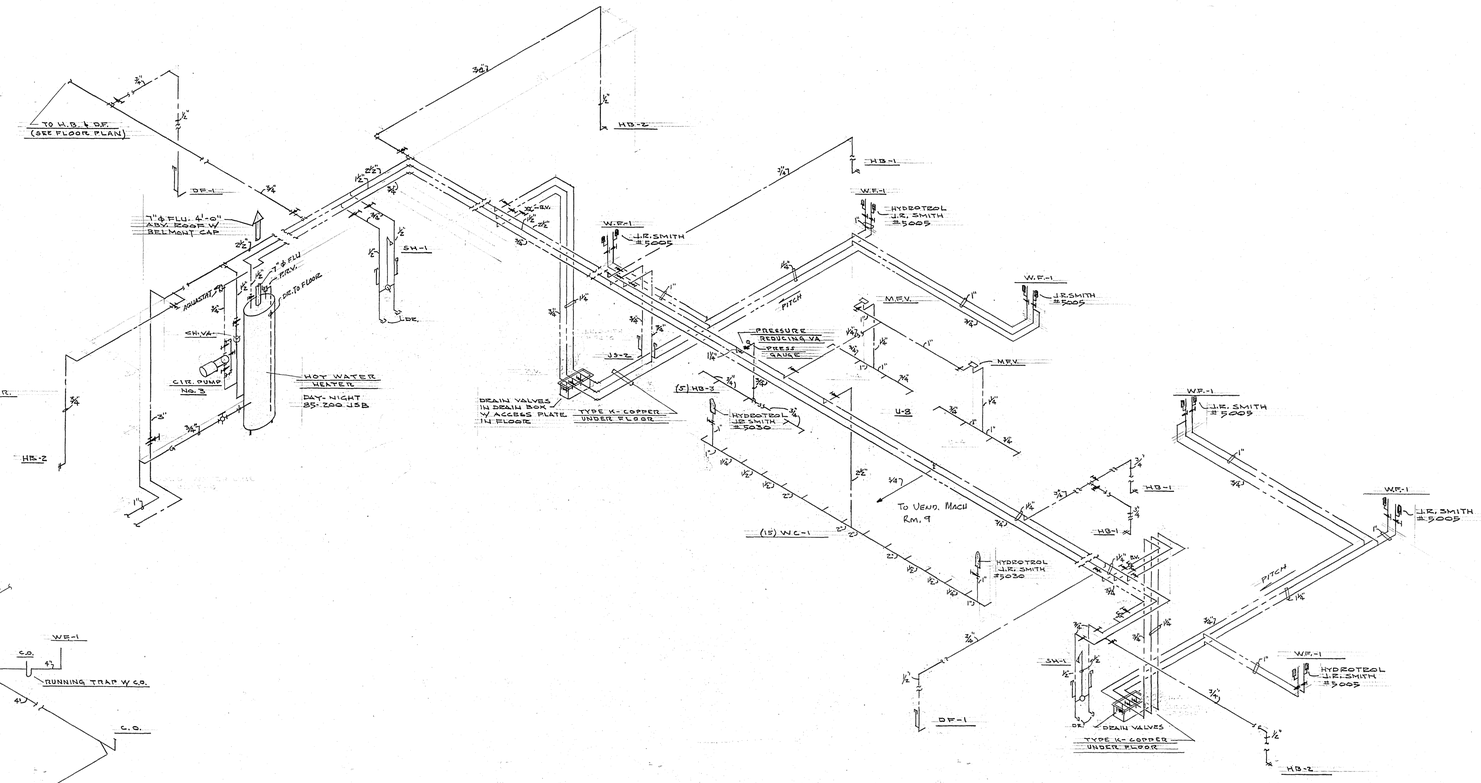

WATER PIPING ISOMETRIC

UNIT-"F" — NO SCALE

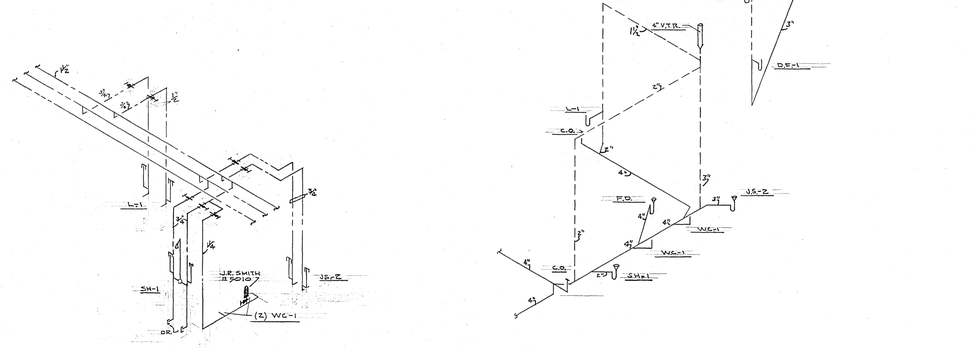

WATER — SOIL, WASTE & VENT

ISOMETRICS ROOMS NO. 26, 27 & 28

UNIT-"O" — NO SCALE

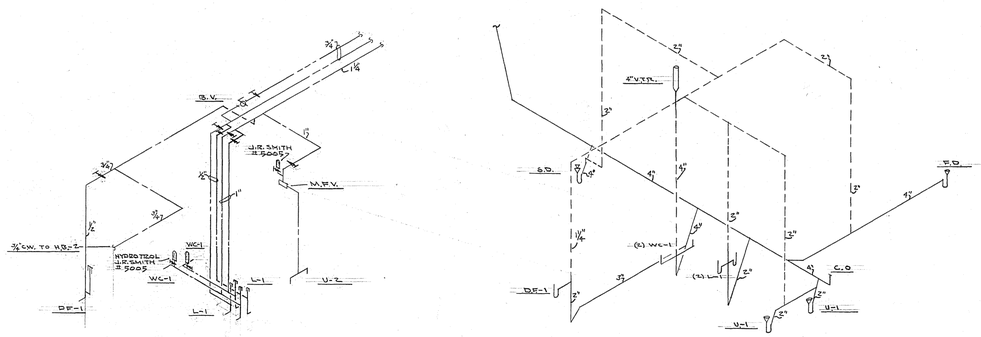

WATER — SOIL, WASTE & VENT

ISOMETRICS ROOMS NO. 17 & 18

UNIT-"O" — NO SCALE

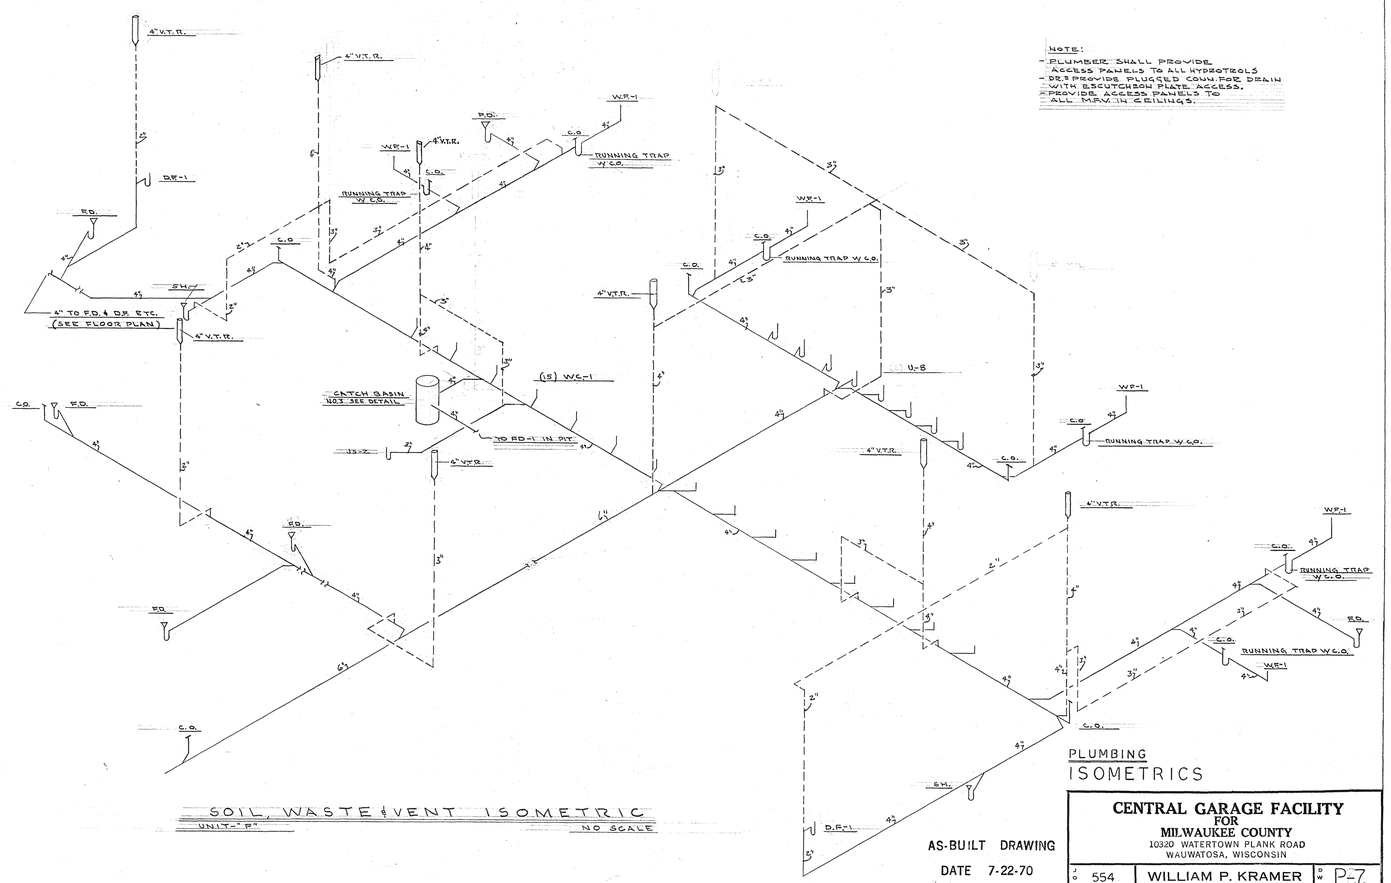

SOIL, WASTE & VENT ISOMETRIC

UNIT-"P" — NO SCALE

NOTE:
- PLUMBER SHALL PROVIDE ACCESS PANELS TO ALL HYDROTROLS
- DF.1 PROVIDE PLUGGED CONN. FOR DRAIN WITH ESCUTCHEON PLATE ACCESS.
- PROVIDE ACCESS PANELS TO ALL M.F.V. IN CEILINGS.

PLUMBING ISOMETRICS

AS-BUILT DRAWING

DATE 7-22-70

CENTRAL GARAGE FACILITY
FOR
MILWAUKEE COUNTY
10320 WATERTOWN PLANK ROAD
WAUWATOSA, WISCONSIN

JOB NO. 554	WILLIAM P. KRAMER ARCHITECT 611 NORTH BROADWAY MILWAUKEE, WISCONSIN	DWG. NO. P-7	
DATE 15-11-66		SHEET NO. 7	OF

RING & DUCHATEAU, INC. CONSULTING ENGINEERS

35599

02-E-10-084 [redacted]

37